

#15



U.S. Public Land Survey Monument Record

Corner ID: E1/4 Sec. 6, T18N-R1E

41801062000

Type of Monument: Set Cast Iron TCP Monument in Concrete

Sec. 6, T18N-R1E

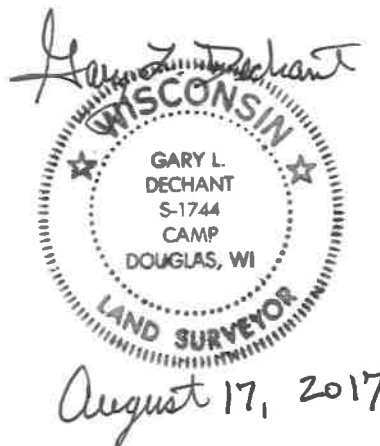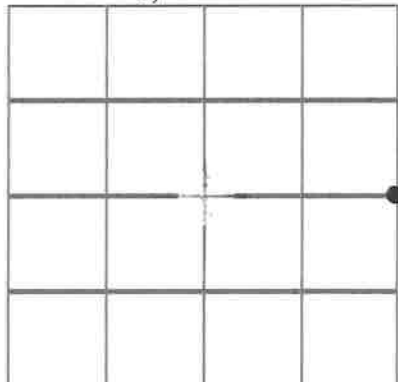

County Coordinates:

Witnesses: Zachariah P. Dechant
Gary L. Dechant

Basis For Monument Location:

(Show info such as history, evidence, testimony, found or method of relocation)

Fred Holden set a stake here in 1903 during work in Section 5 recorded on Page 158 of Vol 1 Historical Books.

There may be an unrecorded survey involving this corner by O. Bergman in the 1950's.

Set corner at intersection of dike to north and west which fits straight line and proportionate measurement basically perfect between section corners.

