

# 47

**U.S. PUBLIC LAND CORNER  
MAINTENANCE**

**Corner ID : SE Sec. 9, T18N-R1E**

**41801090000**

<u>DATE</u>	<u>CREW</u>	<u>MONUMENT TYPE -----</u>
July 6, 2016	Zachariah P. Dechant Gary L. Dechant	Harrison intact, steel post 1/2' north, survey sign 1' east

<u>References:</u>	<u>Bearing</u>	<u>Distance</u>
1) Set 3/4"x24" round iron bar, down 6", 4' NW of 6" White Pine	N37E	24.40'
2) Set 3/4"x24" round iron bar, down 6", 4' east of triple 4"/10"/10" Maple	S33E	28.45'
3) Set 3/4"x24" round iron bar, down 6", 4' SE of 6" Double Maple	S39W	18.68'
4) Set 3/4"x24" round iron bar, down 6", 4' west of 10" White Oak	N18W	23.91'



I, Harley A. Sime, do hereby certify that on the 3rd day of October 1973, I found (evidence) (no evidence) of the SE corner of Section 9, T 18 N, R 1 E, Fourth Principal Meridian, and I re-established said corner according to the Wisconsin Statutes as shown and described hereon.

Dated this 6th day of Feb. 1978.

History of original corner establishment:

Description of corner evidence found:

Corner was set by surveying and computing sections 9, 10, 15, and 16. A Harrison Monument was set.



**See Reverse Side For Maintenance**

County Surveyor **Approved: HARLEY A. SIME**  
Title **MONROE CO. SURVEYOR**

Description of corner and witness monuments, references and accessories used to perpetuate the original or re-established location of this corner:

Witnesses to corner location:

D. Marten

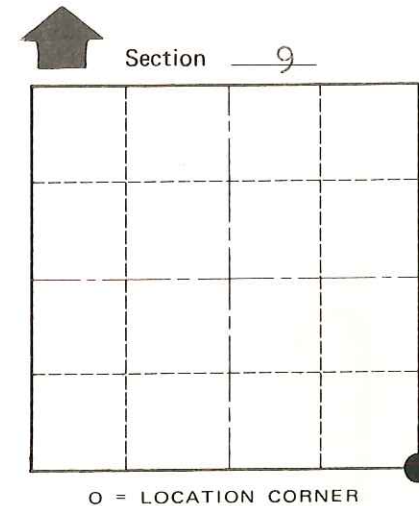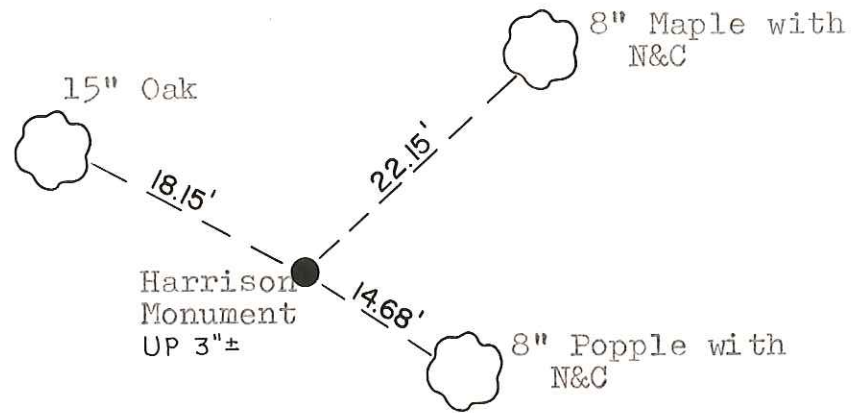

T 18 N R 1 E  
WISCONSIN

SURVEY CONTROL ORDER

Horizontal	_____
Vertical	_____

WISCONSIN COORDINATE SYSTEM

Corner	East (X)	North (Y)	Elevation (Z)	Zone
Control Sta. Name				

City, Village or Town Byron

County of Monroe

**O.K.**

COUNTY SURVEYOR FORM NO. 1