

# JUNEAU COUNTY SURVEY MONUMENT RECORD

CORNER NO. 61  
SECTION 18  
TOWN 18 N.  
RANGE 2 E.

TYPE OF MONUMENT: MONROE COUNTY TCP MONUMENT FOUND

JUNEAU COUNTY COORDINATES NAD 83/91  
NORTHING: 240,051.78  
EASTING: 400,758.32

■ = CORNER MONUMENT RESTORED

BASIS FOR MONUMENT LOCATION  
(USE REVERSE SIDE IF NECESSARY)

SHOW INFO SUCH AS: HISTORY OF CORNER, WITH REFERENCE TO VOLUME AND PAGE DATES, SURVEYOR; EXACT DESCRIPTION OF MONUMENT PLACED OR FOUND, IF LOCATION COMPUTED, BY TAPED OR EDM TRAVERSE; LANDOWNER REMARKS, ETC.

MONROE COUNTY TCP MONUMENT FOUND AS PER TIE SHEET DATED 8/10/1989 BY JAMES CARROLL.




LOCATION

## LEGEND

- = MONROE COUNTY TCP MONUMENT FOUND
- ∧ = GOVERNMENT SIGN SET
- = 3/4" X 24" IRON ROD SET
- TREE TIES ARE FOUND RAILROAD SPIKES


TIE SKETCH  
(SHOW AT LEAST FOUR TIES)

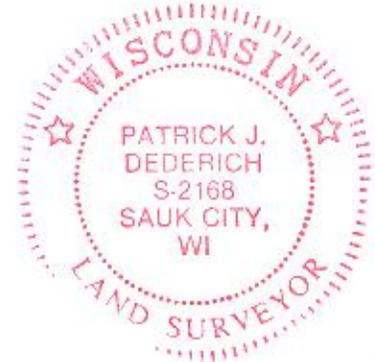

CERTIFIED CORRECT

*Patrick J. Dederich*  
REGISTERED LAND SURVEYOR

DATE 4/18/2010

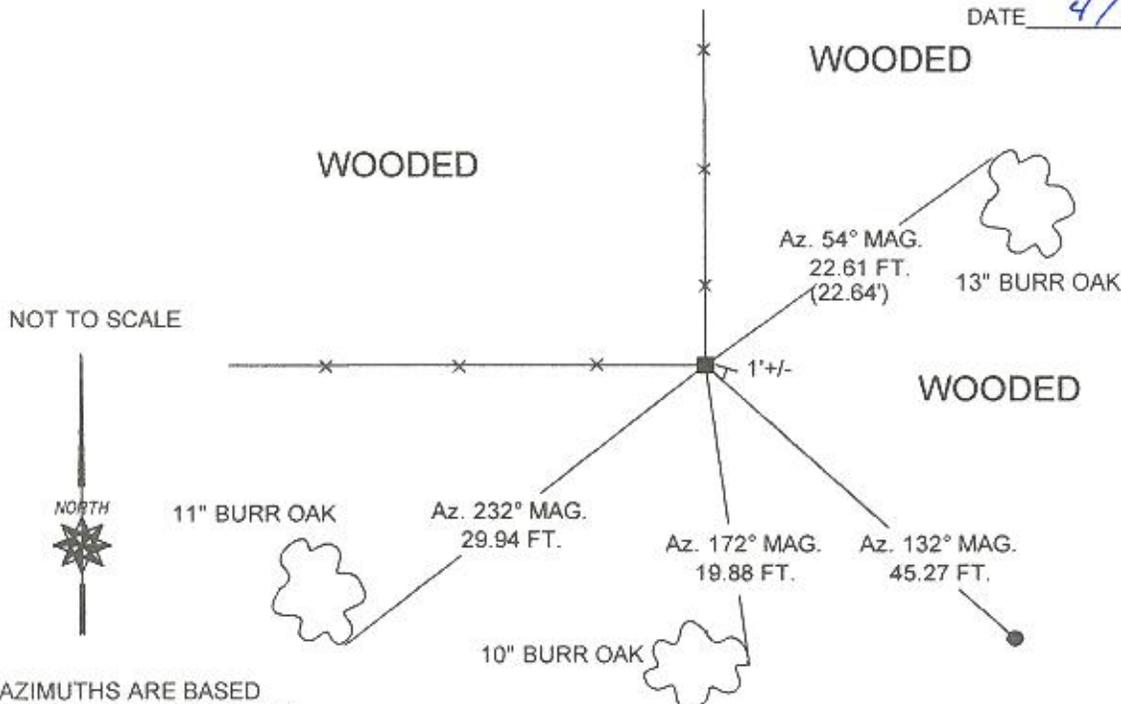

NOT TO SCALE



AZIMUTHS ARE BASED  
ON THE JUNEAU COUNTY  
COORDINATE SYSTEM  
UNLESS OTHERWISE NOTED

WOODED

61

JUNEAU COUNTY

Survey Monument Record

TYPE OF MONUMENT: HARRISON

STATE PLANE COORDINATES: N \_\_\_\_\_

E \_\_\_\_\_

ELEVATION — M.S.L. DATUM: \_\_\_\_\_

THETA ANGLE: \_\_\_\_\_


FIELD BOOK: \_\_\_\_\_ PAGE \_\_\_\_\_

CORNER NO. \_\_\_\_\_

SECTION 19

TOWN 18

RANGE 2

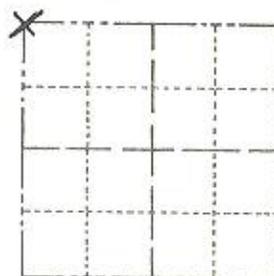

LOCATION  
(Indicated by 'X')

SEAL:



BASIS FOR MONUMENT LOCATION

(Use reverse side if necessary)

Show info such as: History of corner, with reference to Vol. and pg, dates, surveyor; exact description of monument replaced; if location computed, by taped or EDM traverse; landowner remarks, etc.

*Tied Marro  
County marker*


CERTIFIED CORRECT:

*James J. Carroll*  
Registered Land Surveyor

DATE: 8-10-89

TIE SKETCH

(Show at least four ties)

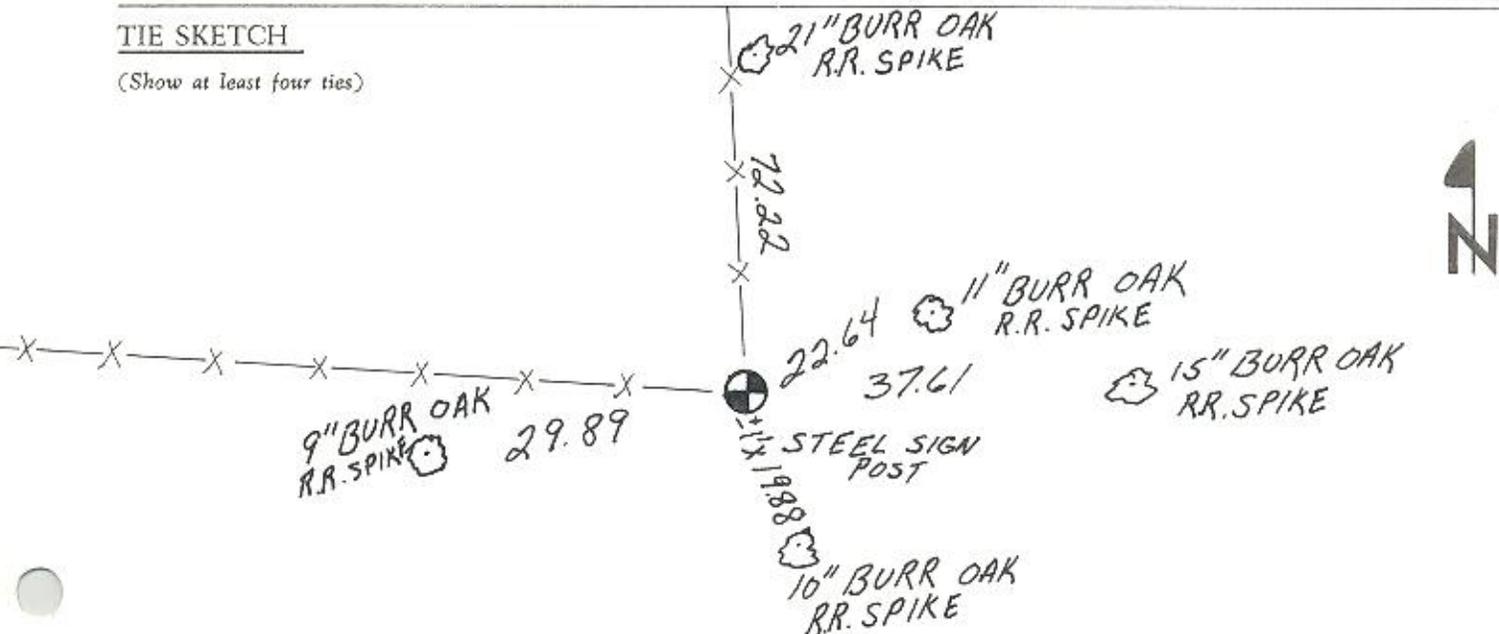

41801130000

I, William C. Jung, do hereby certify that on the 1st day of June 1982, I found ~~(evidence)~~ (no evidence) of the SE corner of Section 13, T 18 N, R 1 E Fourth Principal Meridian, and I re-established said corner according to the Wisconsin Statutes as shown and described hereon.

Dated this 22nd day of Feb. 1983.

William C. Jung

Deputy County Surveyor

Title

History of corner establishment since Original Government Survey

Years ago, Patterson, from Juneau County, was at this corner. Doug Malliet set an iron bar at this corner in January of 1976. He set it at a location computed out by Marten.

Description of corner evidence found:


The bar set by Malliet was in error. I removed it. After surveying out Section 13, I set the corner at a location that best fits the existing monuments and occupation in Section 13. It also fits the Town/County line. I measure about  $NO^{\circ}45'56''E$ , 2634.76' to the E1/4 of Section 13 and  $SO^{\circ}43'47''W$ , 2636.02' to the E1/4 of Section 24.

Description of corner and witness monuments, references and accessories used to perpetuate the original or re-established location of this corner:

Witnesses to corner location:

William Jung

Bryan Meyer

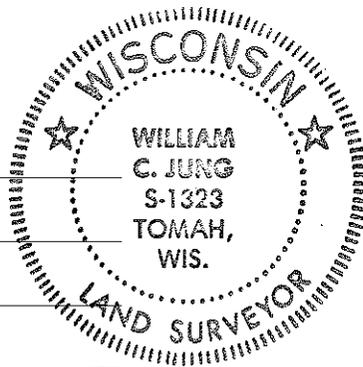

8" Double Maple



30.57'

8" White Oak



22.44'


Set Harrison, up 2", with post South of marker

(I found remnants of an old North-South fence which fit the corner very good.)



10" Double White Oak

6.11'

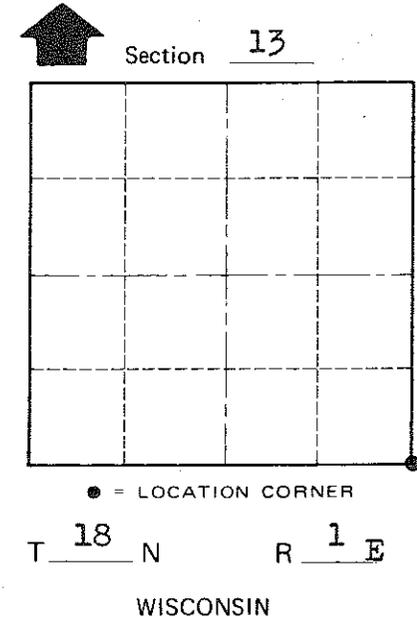

Approved: **HARLEY A. SIME**  
**MONROE CO. SURVEYOR**

Note: All bearing trees are double blazed. Distances are to nails set in blazes on the sides of the trees.

SURVEY CONTROL ORDER

Horizontal	_____
Vertical	_____

WISCONSIN COORDINATE SYSTEM

Corner	East (X)	North (Y)	Elevation (Z)	Zone
Control Sta. Name				

~~City, Village or~~ Town Byron  
County of Monroe

COUNTY SURVEYOR FORM NO. 1