

# 119

**U.S. PUBLIC LAND CORNER  
MAINTENANCE**


**Corner ID : E1/4 Sec.35, T18N-R2W  
21802352000**

<u>DATE</u>	<u>CREW</u>	<u>MONUMENT TYPE</u> -----
August 5, 2015	Zachariah P. Dechant Gary L. Dechant	Existing Harrison in centerline of Flatiron Ave 238' east of Flannigan Road

References:

	<u>Bearing</u>	<u>Distance</u>
1) Set 3/4"x24" hex iron bar, down 12" in field	N18E	54.35'
2) Set 3/4"x24" hex iron bar, down 12" in field	S56E	43.82'
3) Set 3/4"x24" hex iron bar down 6", 8' east of two young spruce	S18W	34.89'
4) Set 3/4"x24" hex iron bar, down 6", 7' west of 8" Chestnut	N56W	55.23'

**Harrison and reference markers set on straight lines.**

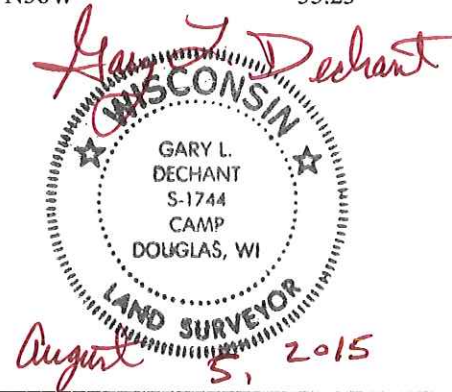

I, Harley A. Sime, do hereby certify that on the 23rd day of June 1976, I found (evidence) ~~(no evidence)~~ of the W 1/4 corner of Section 36, T 18 N, R 2 W, Fourth Principal Meridian, and I re-established said corner according to the Wisconsin Statutes as shown and described hereon.

Dated this 1st day of March 1978.

History of original corner establishment:

No known history recorded since the original government survey.

Description of corner evidence found:

Set on line and equidistant between the section corners.

**See Reverse Side For Maintenance**

County Surveyor  
Title

**Approved: HARLEY A. SIME**  
**MONROE CO. SURVEYOR**

Description of corner and witness monuments, references and accessories used to perpetuate the original or re-established location of this corner:

Witnesses to corner location:

D. Malliet

C. Pietz

24" Burr Oak blazed and with nail & cap



90.54'

Set 1 1/4" iron pipe, 2'± west of fence corner

North



32.25'

RD.

1.8'


Set Harrison, down 2 1/2'

24.53'

138.11'

Set iron drive shaft


Power Pole with N&C

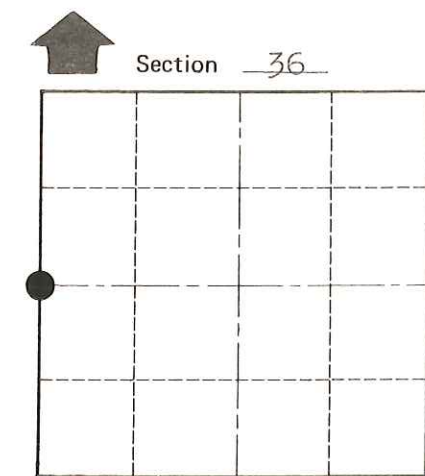

O = LOCATION CORNER

T 18 N R 2 W

WISCONSIN

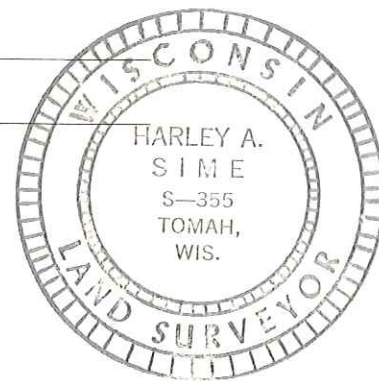

SURVEY CONTROL ORDER

Horizontal	_____
Vertical	_____

WISCONSIN COORDINATE SYSTEM

Corner	East (X)	North (Y)	Elevation (Z)	Zone
Control Sta. Name				

City, Village or Town Greenfield

County of Monroe

COUNTY SURVEYOR FORM NO. 1