

18

**U.S. PUBLIC LAND CORNER
MAINTENANCE**

Corner ID : E1/4, Sec. 3, T18N-R2W

21802032000

<u>DATE</u>	<u>CREW</u>	<u>MONUMENT TYPE</u>
March 9, 2017	Zachariah P. Dechant Gary L. Dechant	Existing 1-3/4" iron pipe in north-south fence Set new sign 2' north

<u>References:</u>	<u>Bearing</u>	<u>Distance</u>
1) Set 3/4"x24" round iron bar, down 12" in field	N40E	24.16'
2) Set 3/4"x24" round iron bar, down 6", in old north-south fence	South	18.25'
3) Set 3/4"x24" hex iron bar, down 6", 4' NE of 16" Maple (BT)	S21W	35.69'
4) Set 3/4"x 24" hex iron bar, down 4' SE of 8" Maple	N76W	52.94'



I, Bryan H. Meyer, do hereby certify that on the 23rd day of October 1984, I found (evidence) ~~(no evidence)~~ of the West 1/4 corner of Section 2, T 18 N, R 2 W Fourth Principal Meridian, and I re-established said corner according to the Wisconsin Statutes as shown and described hereon.

Dated this 4th day of Dec. 1984.

Bryan H. Meyer
Deputy County Surveyor
Title

History of corner establishment since Original Government Survey

Fred Holden was at this corner in September of 1911.

Description of corner evidence found:

I found a 1 3/4" iron pipe 21.6 feet North of a three way fence corner. This pipe fits better proportionately on the West line of Section 2 than does the fence corner. I am also of the opinion that this pipe was set by Holden in the 1911 survey, therefore I accepted the pipe as the corner.



COUNTY SURVEYOR FORM NO. 1

Description of corner and witness monuments, references and accessories used to perpetuate the original or re-established location of this corner:

Crew: Meyer, Wilhite, Lund
Date: October 23, 1984 - 2:30 P.M.
Weather: Overcast, Windy, 40°±
Witnesses to corner location:



Bryan H. Meyer
Dallas Wilhite
Jim Lund

Approved: Harley A. Sime
Monroe County Surveyor

SURVEY CONTROL ORDER

Horizontal _____
Vertical _____

Corner	East (X)	North (Y)	Elevation (Z)	Zone
Control Sta. Name				

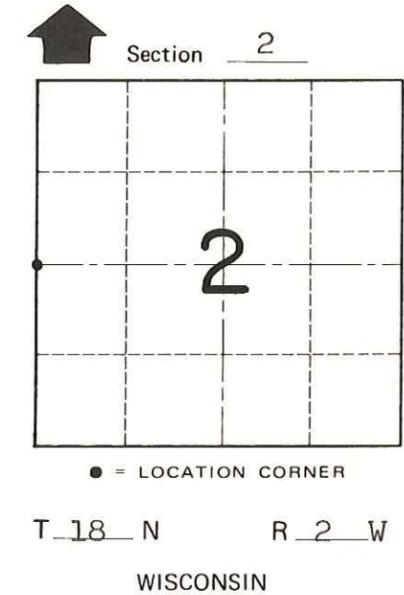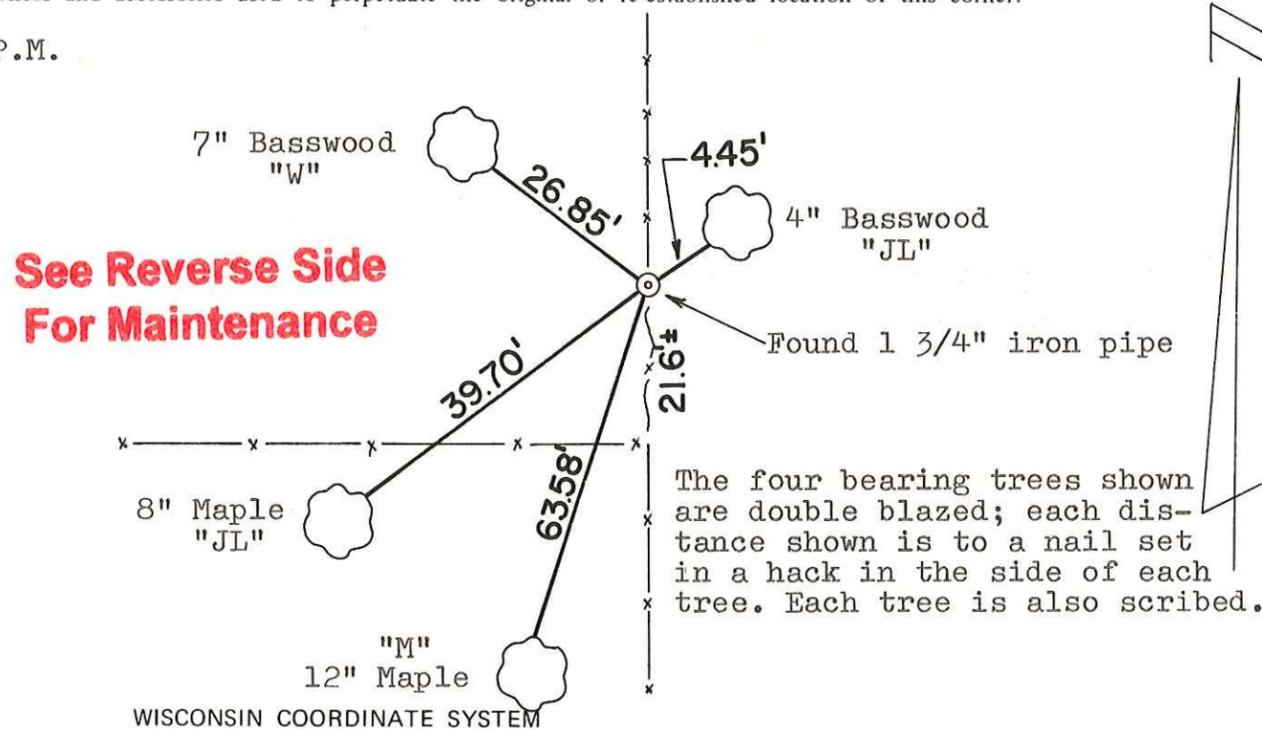

~~City, Village or~~ Town of Greenfield
County of Monroe