

CERTIFICATE

CERTIFIED LAND CORNER

No. 56 B

21803162020

I, Lawrence A. Feddersen, do hereby certify that on the 7th day of September, 1978, I found ~~(evidence)~~ (no evidence) of the Center 1/4 corner of Section 16, T 18 N, R 3 W, Fourth Principal Meridian, and I re-established said corner according to the Wisconsin Statutes as shown and described hereon.

Dated this 13th day of September 1978

Lawrence A. Feddersen
Registered Land Surveyor
Title

History of original corner establishment:

Description of corner evidence found:

Set 1 1/4" x 30" Round Iron Bar at the intersection of the North-South Quarter line and the East-West Quarter line.

Description of corner and witness monuments, references and accessories used to perpetuate the original or re-established location of this corner:



Set 1 1/4" x 30" Round Iron Bar

Witnesses to corner location:

Lawrence A. Feddersen
D. J. Malliet
S. Towne

Drawn by county Surveyor's office

COUNTY SURVEYOR FORM NO. 1

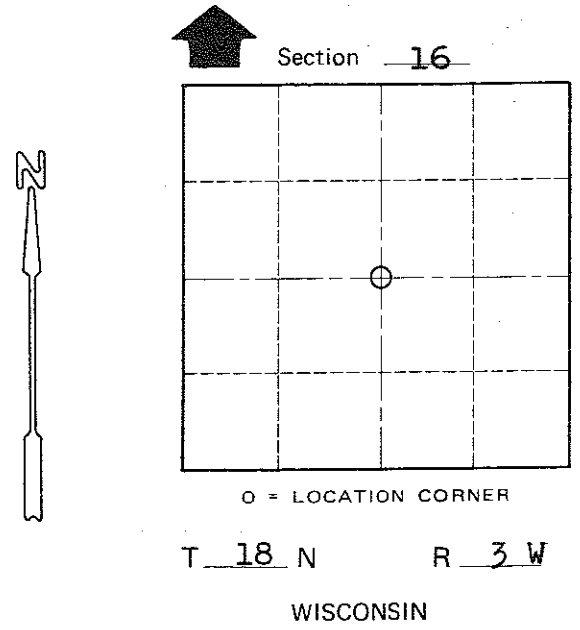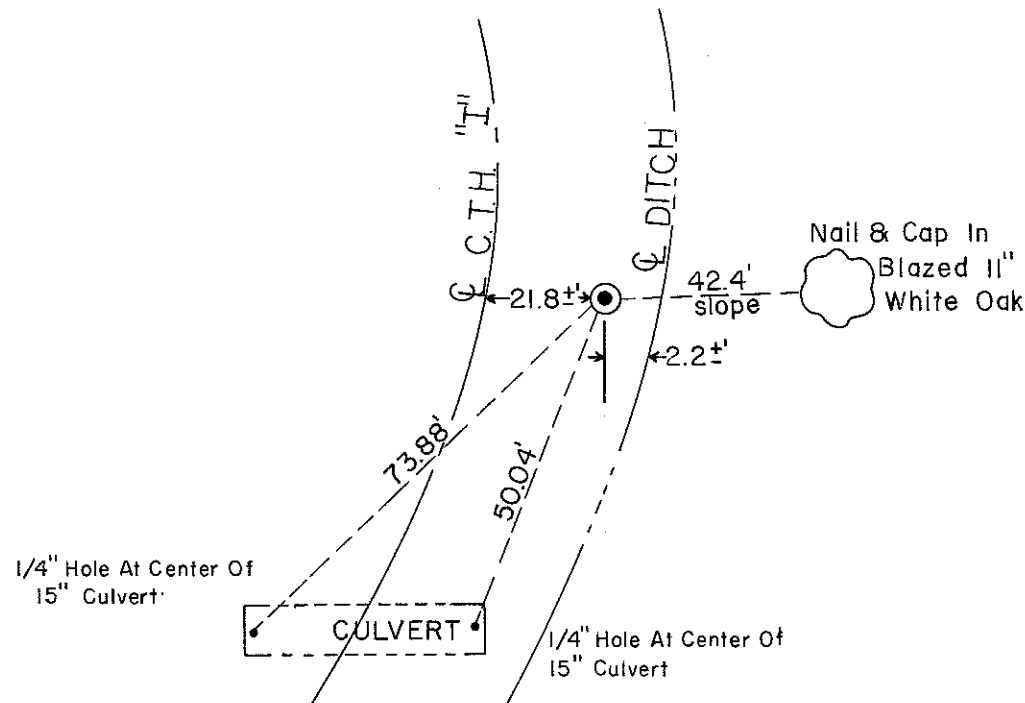

SURVEY CONTROL ORDER

Horizontal	_____
Vertical	_____

WISCONSIN COORDINATE SYSTEM

Corner	East (X)	North (Y)	Elevation (Z)	Zone
Control Sta. Name				

City, Village or Town Lafayette

County of Monroe