

CERTIFICATE

CERTIFIED LAND CORNER

No. 71


21803180000

I, Lawrence A. Feddersen, do hereby certify that on the 7th day of September 1978, I found (evidence) (no evidence) of the Southeast corner of Section 17, T 18 N, R 3 W, Fourth Principal Meridian, and I re-established said corner according to the Wisconsin Statutes as shown and described hereon.

Dated this 13 day of Sept. 1978.

Lawrence A. Feddersen

REGISTERED LAND SURVEYOR S-122
Title

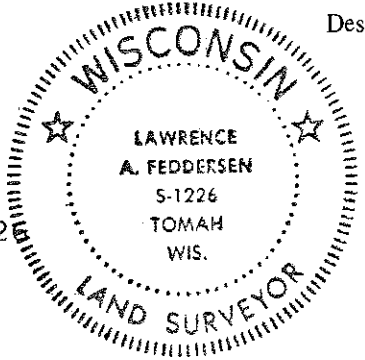

History of original corner establishment:



In December, 1910, Fred Holden visited this corner and found a stone set by a former surveyor.

Description of corner evidence found:

We conducted a very extensive search for the bearing tree stumps and stone, as indicated in Holden's survey, at and in the the proximity of several computed locations for this corner; however, we did not find the stone or it's accessories of record. A temporary corner location was established on line between the NW corner of Section 29 and the W $\frac{1}{2}$ corner of Section 17, and at 2/3 of the total distance, between said corners, to the North of the NW corner of Section 29. A bearing was computed between a point at the SW corner of Section 18 and the temporary corner location. The permanent corner was then located on the Easterly extension of the aforementioned bearing and at the record Government distance from the SW corner of Section 18. This location

Description of corner and witness monuments, references and accessories used to perpetuate the original or re-established location of this corner: agrees fairly well with the occupied North-South fence. Section 17

Witnesses to corner location:
Lawrence A. Feddersen
Douglas J. Malliet
Steve Towne

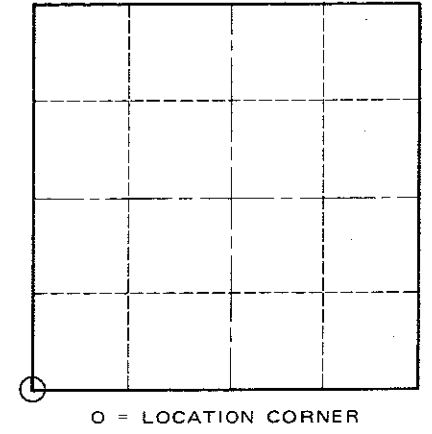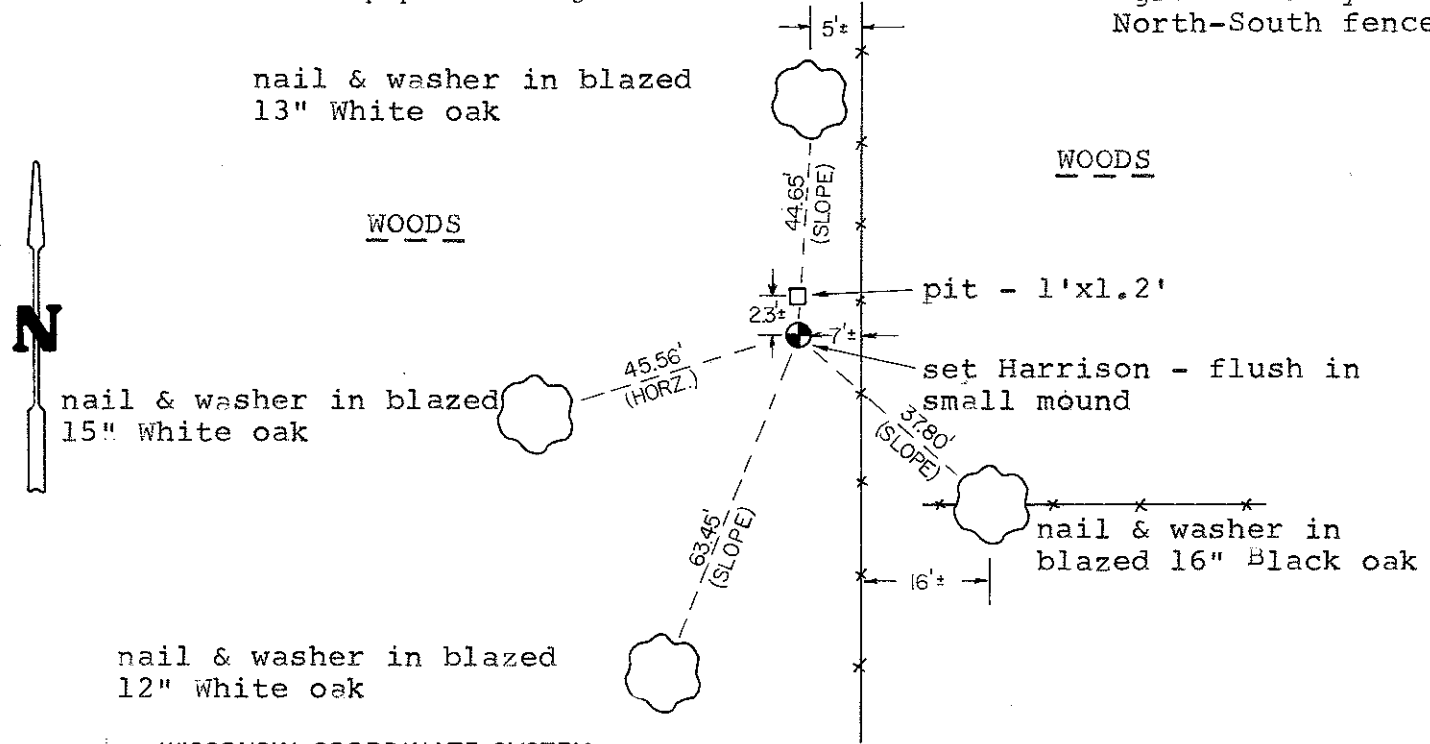

SURVEY CONTROL ORDER

| | |
|------------|-------|
| Horizontal | _____ |
| Vertical | _____ |

WISCONSIN COORDINATE SYSTEM

| Corner | East (X) | North (Y) | Elevation (Z) | Zone |
|-------------------|----------|-----------|---------------|------|
| Control Sta. Name | | | | |

~~City, Village or Town~~ of LAFAYETTE

County of MONROE

COUNTY SURVEYOR FORM NO. 1