

CERTIFICATE

CERTIFIED LAND CORNER

No. 31

21803060000

I, Lawrence A. Feddersen, do hereby certify that on the 6th day of September 19 78, I found (evidence) (~~NO EVIDENCE~~) of the Northwest corner of Section 8, T18 N, R 3 W, Fourth Principal Meridian, and I re-established said corner according to the Wisconsin Statutes as shown and described hereon.

Dated this 13 day of Sept. 19 78.

Lawrence A. Feddersen

REGISTERED LAND SURVEYOR S-1226
Title



History of original corner establishment:

No subsequent history of corner perpetuation since the original U.S. Government Survey.

Description of corner evidence found:

This corner was re-established at the intersection of the centerline of Beaver Ave. and the Southerly extention of a fence to the North. The distance South to the SW corner of Section 8 agrees well with the Government distance. The bearing East to the NE corner of Section 8 matches well with the bearing of the South line of Section 8. Although the distance to the NE corner of Section 8 does not agree with the Government notes, it does match well with the occupied North-South quarter line when it is split in half.



Description of corner and witness monuments, references and accessories used to perpetuate the original or re-established location of this corner:

Witnesses to corner location:

Lawrence A. Feddersen

Douglas J. Malliet

Steve Towne

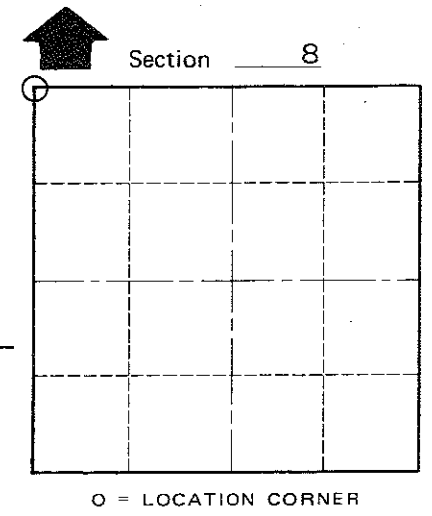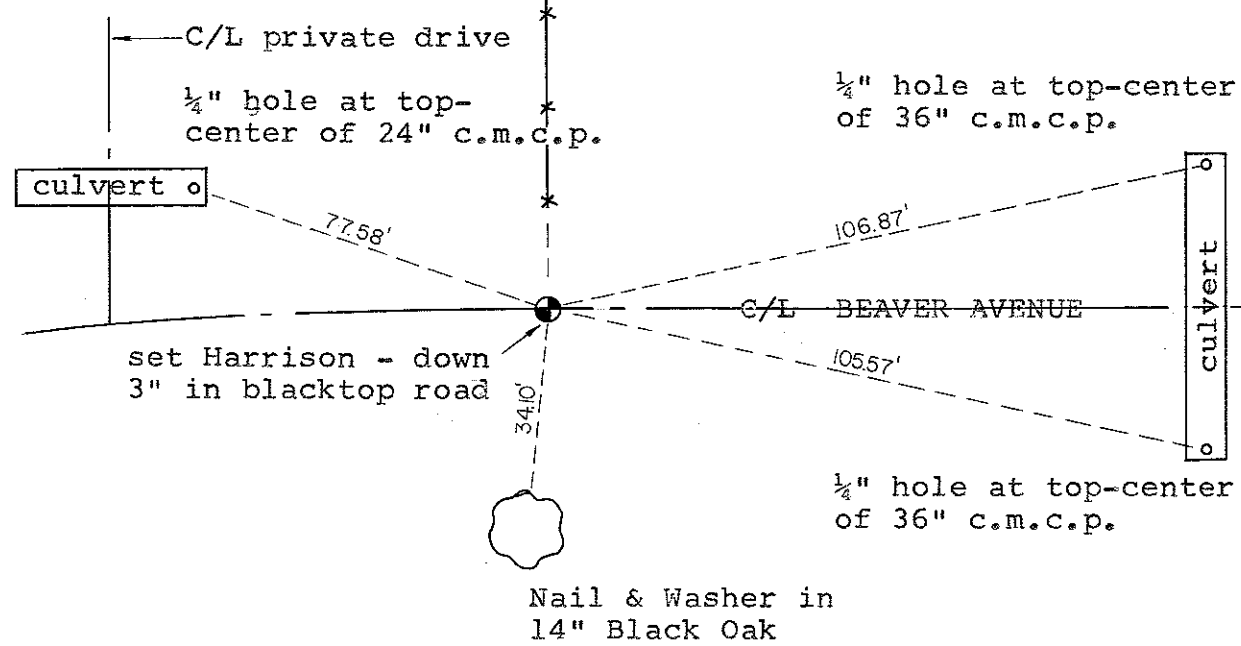

T 18 N R 3 W

WISCONSIN

COUNTY SURVEYOR FORM NO. 1



SURVEY CONTROL ORDER

Horizontal	_____
Vertical	_____

WISCONSIN COORDINATE SYSTEM

Corner	East (X)	North (Y)	Elevation (Z)	Zone
Control Sta. Name				

~~City, Village or Town~~ of LAFAYETTE

County of MONROE