


ORIGINAL SURVEY DATA

BY \_\_\_\_\_  
DATE \_\_\_\_\_

SURVEYED BY G. A. Sime	CONTRACT DATE March 1978	COUNTY MONROE [REDACTED]	TOWN-VILLAGE-CITY Little Falls	SECTION 4	TOWNSHIP 18N	RANGE 4W
---------------------------	-----------------------------	-----------------------------	-----------------------------------	--------------	-----------------	-------------

NOTES  $\frac{80.0 \text{ chs.}}{5392.2'}$

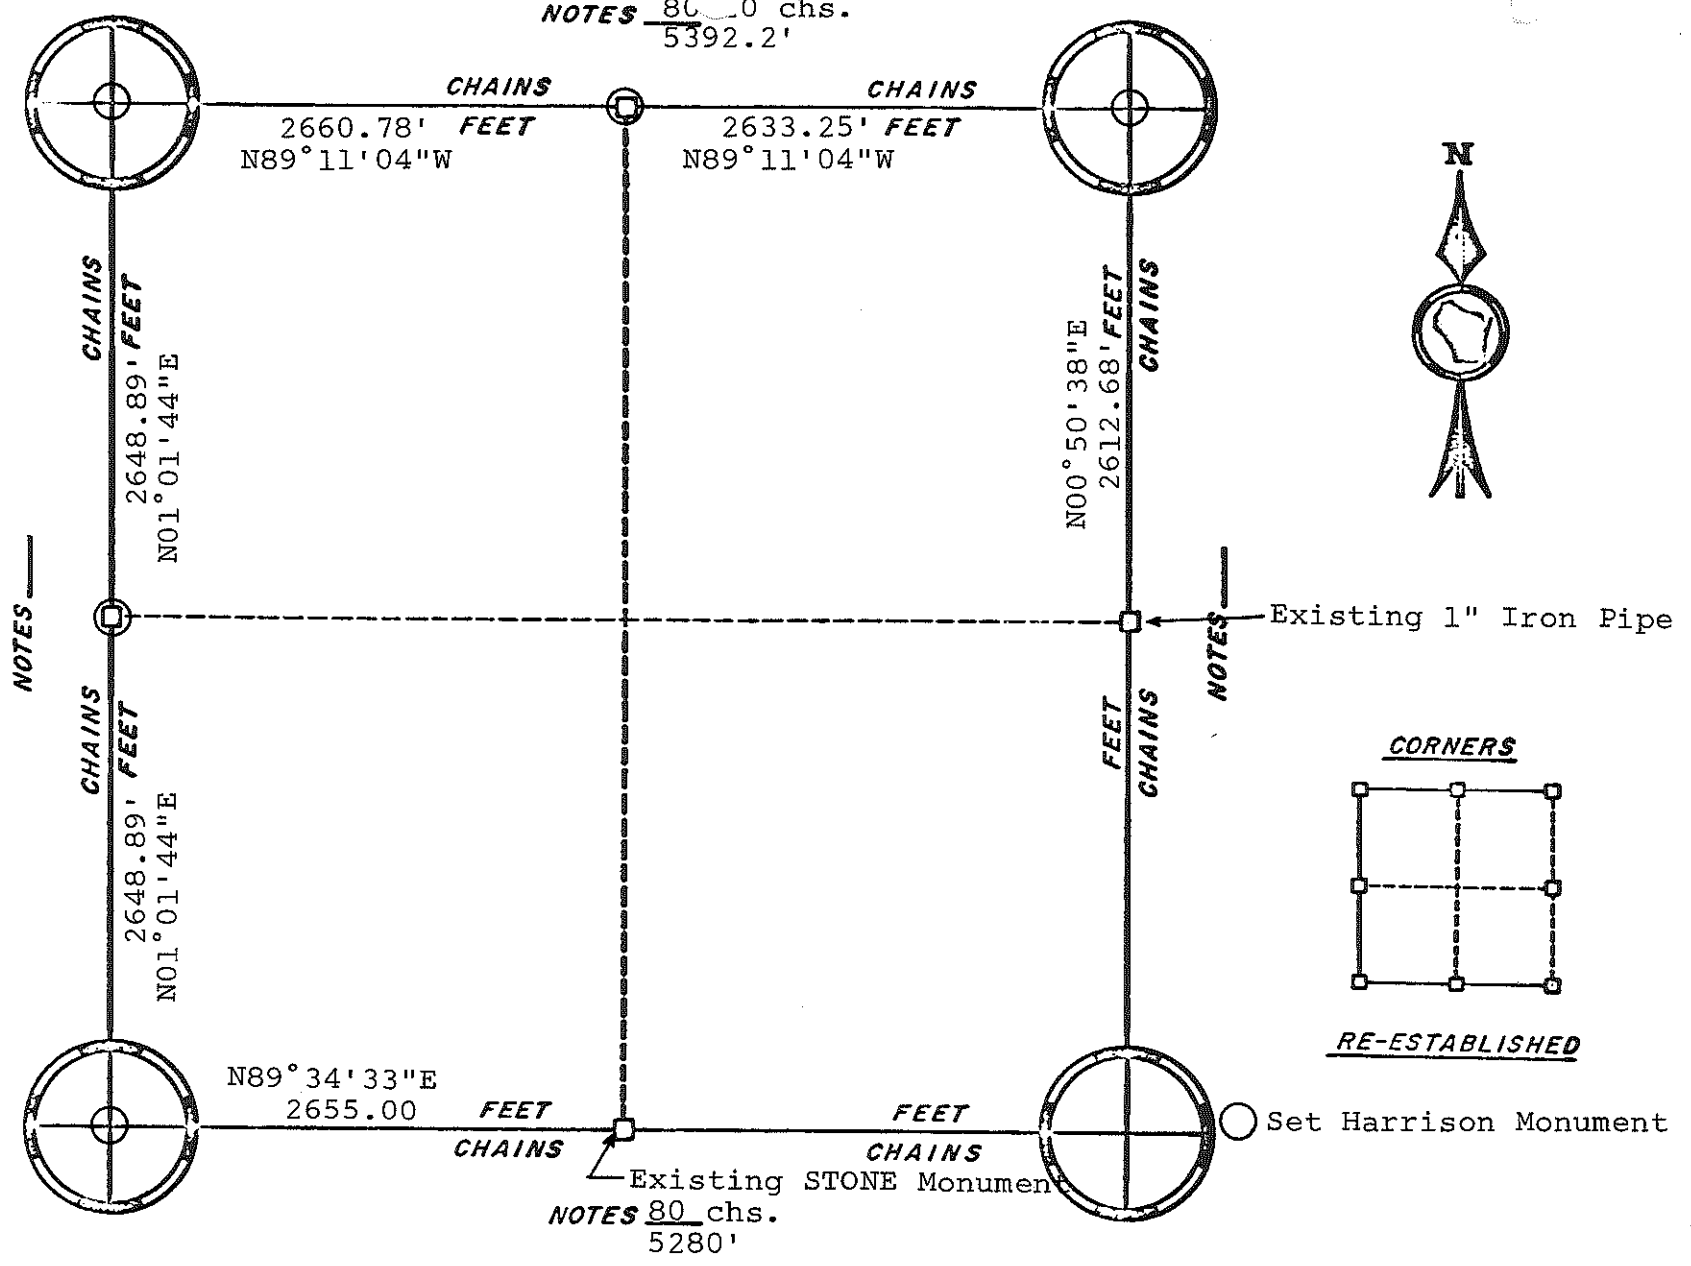


ORIGINAL SURVEY DATA

BY [REDACTED]  
DATE Jan. 9, 1980

SURVEYED BY	CONTRACT DATE	COUNTY	MONROE	TOWN-VILLAGE-CITY	SECTION	TOWNSHIP	RANGE
L. Feddersen M. Heidecke	Jan. 9, 1980	[REDACTED]		Little Falls	8	T 18 N	R 4 W

NOTES —

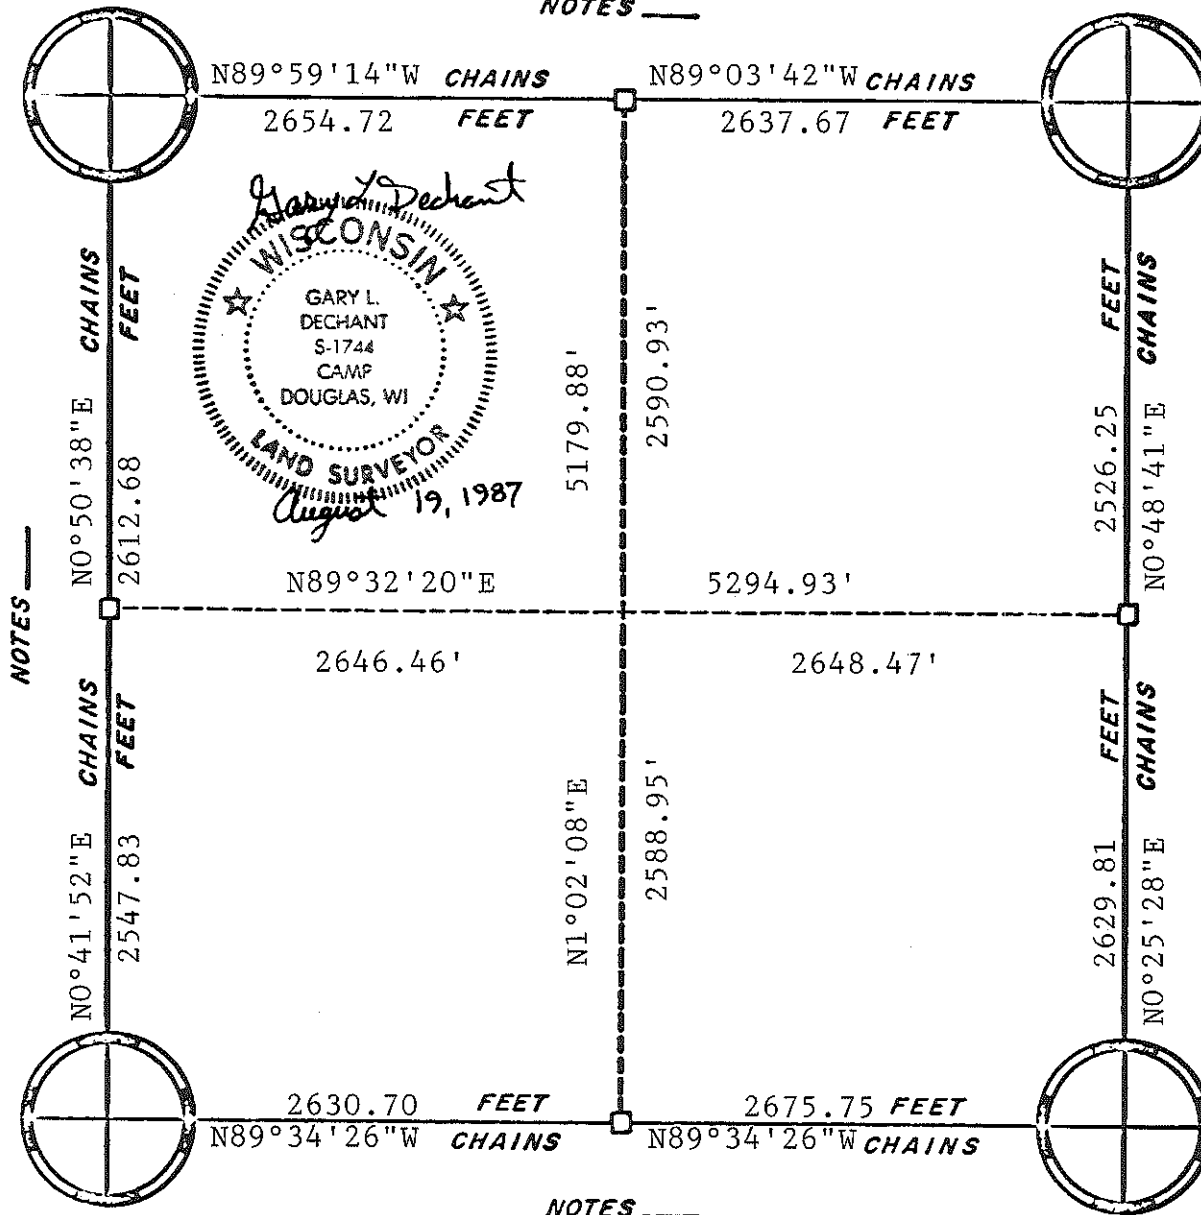


NOTES —

NOTES —

NOTES —

CORNERS

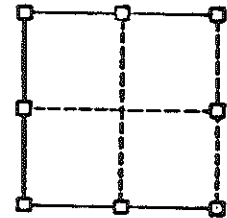

RE-ESTABLISHED




BY

DATE

ORIGINAL SURVEY DATA

SURVEYED BY Gary L. Dechant	CONTRACT DATE Aug. 19, 1987	COUNTY MONROE	TOWN-VILLAGE-CITY Little Falls	SECTION 9	TOWNSHIP 18N	RANGE 4W
--------------------------------	--------------------------------	------------------	-----------------------------------	--------------	-----------------	-------------

NOTES \_\_\_\_\_

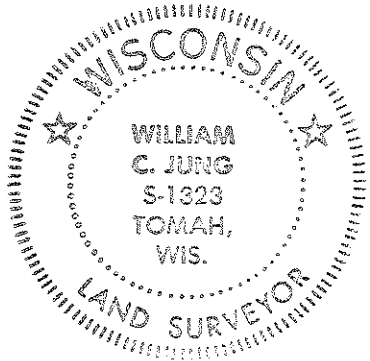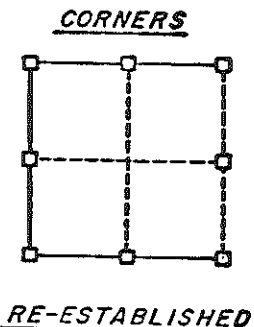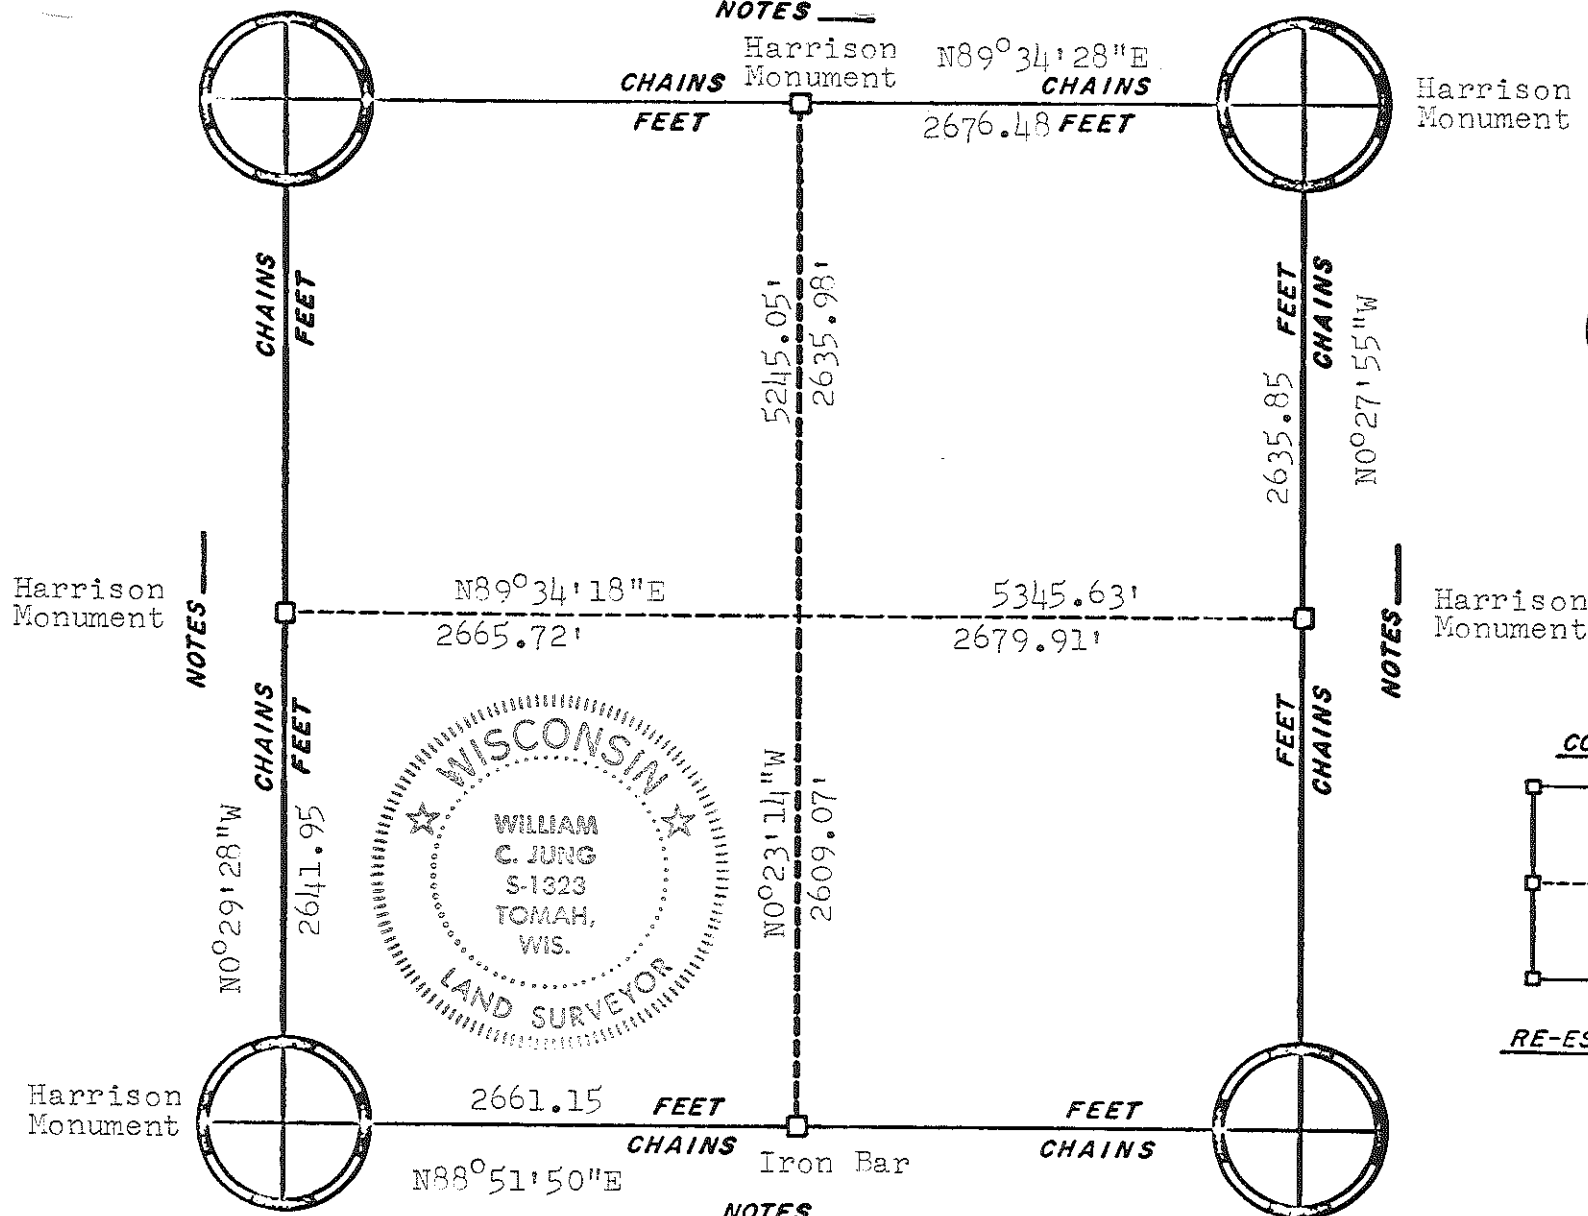


**ORIGINAL SURVEY DATA**

BY *W.C.J.*

DATE 3/5/79

SURVEYED BY W. C. Jung	CONTRACT DATE Nov. 1978	COUNTY MONROE	TOWN-VILLAGE-CITY Little Falls	SECTION 16	TOWNSHIP 18N	RANGE 4W
---------------------------	----------------------------	------------------	-----------------------------------	---------------	-----------------	-------------

Set Harrison Monument

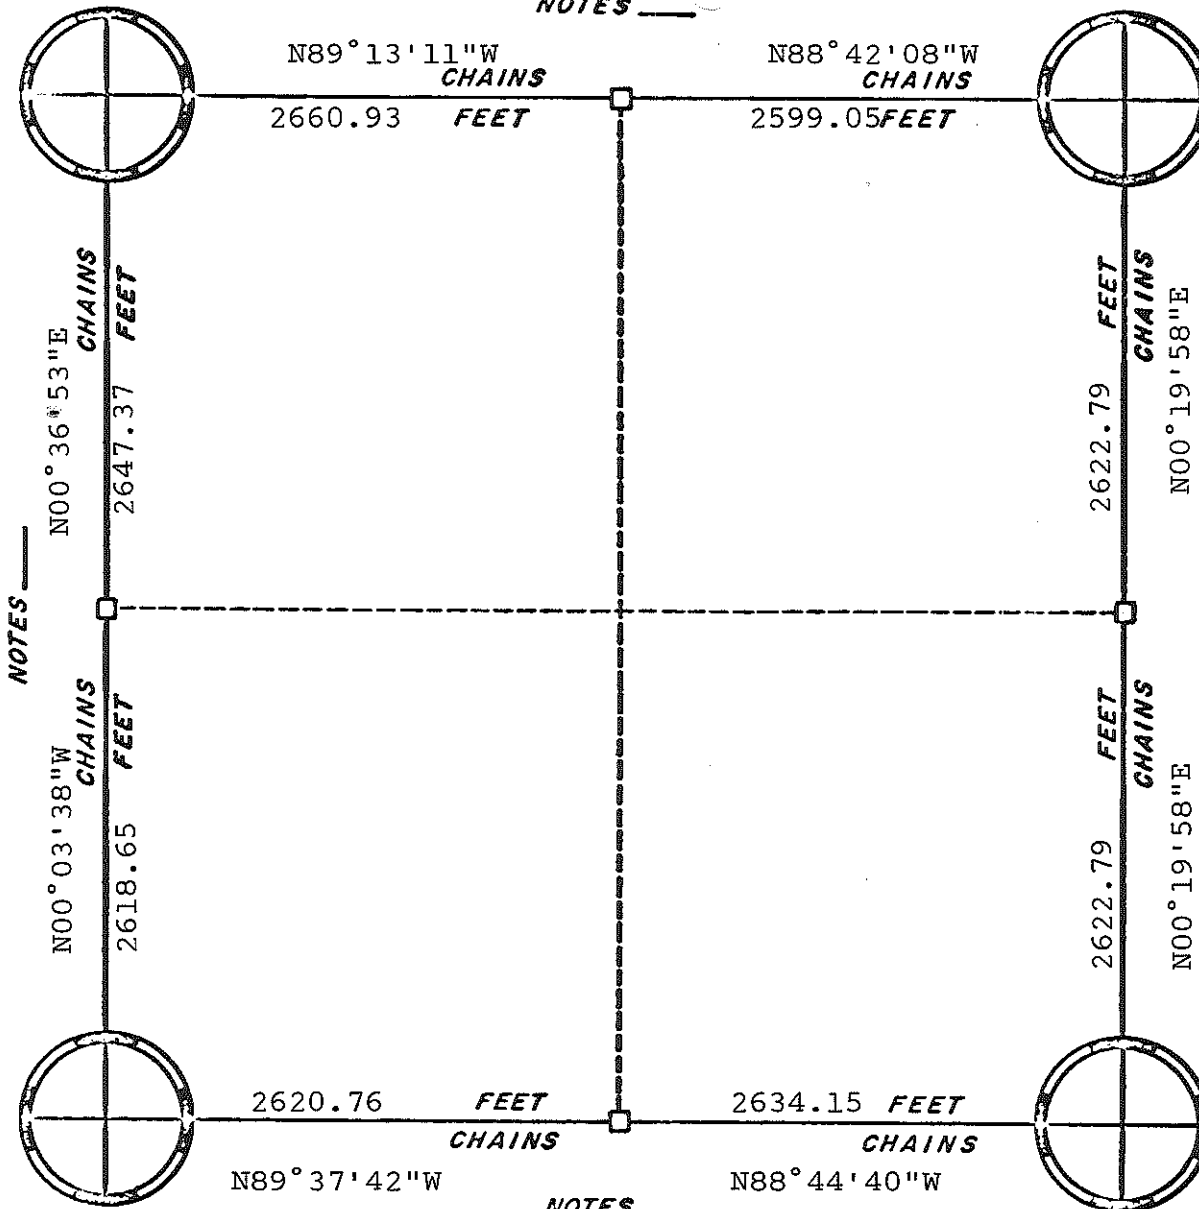


Set Harrison Monument



Set Harrison Monument

NOTES \_\_\_\_\_

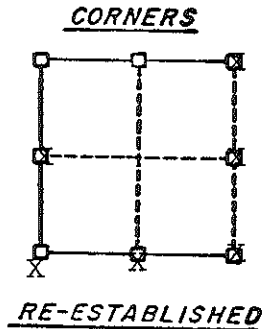

Set Harrison Monument

NOTES \_\_\_\_\_

Set Harrison Monument

Set Harrison Monument

ORIGINAL SURVEY DATA


BY \_\_\_\_\_

DATE August 27, 1979

SURVEYED BY M. Heidecke L. Feddersen	CONTRACT DATE	COUNTY MONROE	TOWN-VILLAGE-CITY Sparta	SECTION 25	TOWNSHIP 18	RANGE 4 W
--	---------------	---------------	-----------------------------	---------------	----------------	--------------

80.50 chs.=531' 0"

NOTES

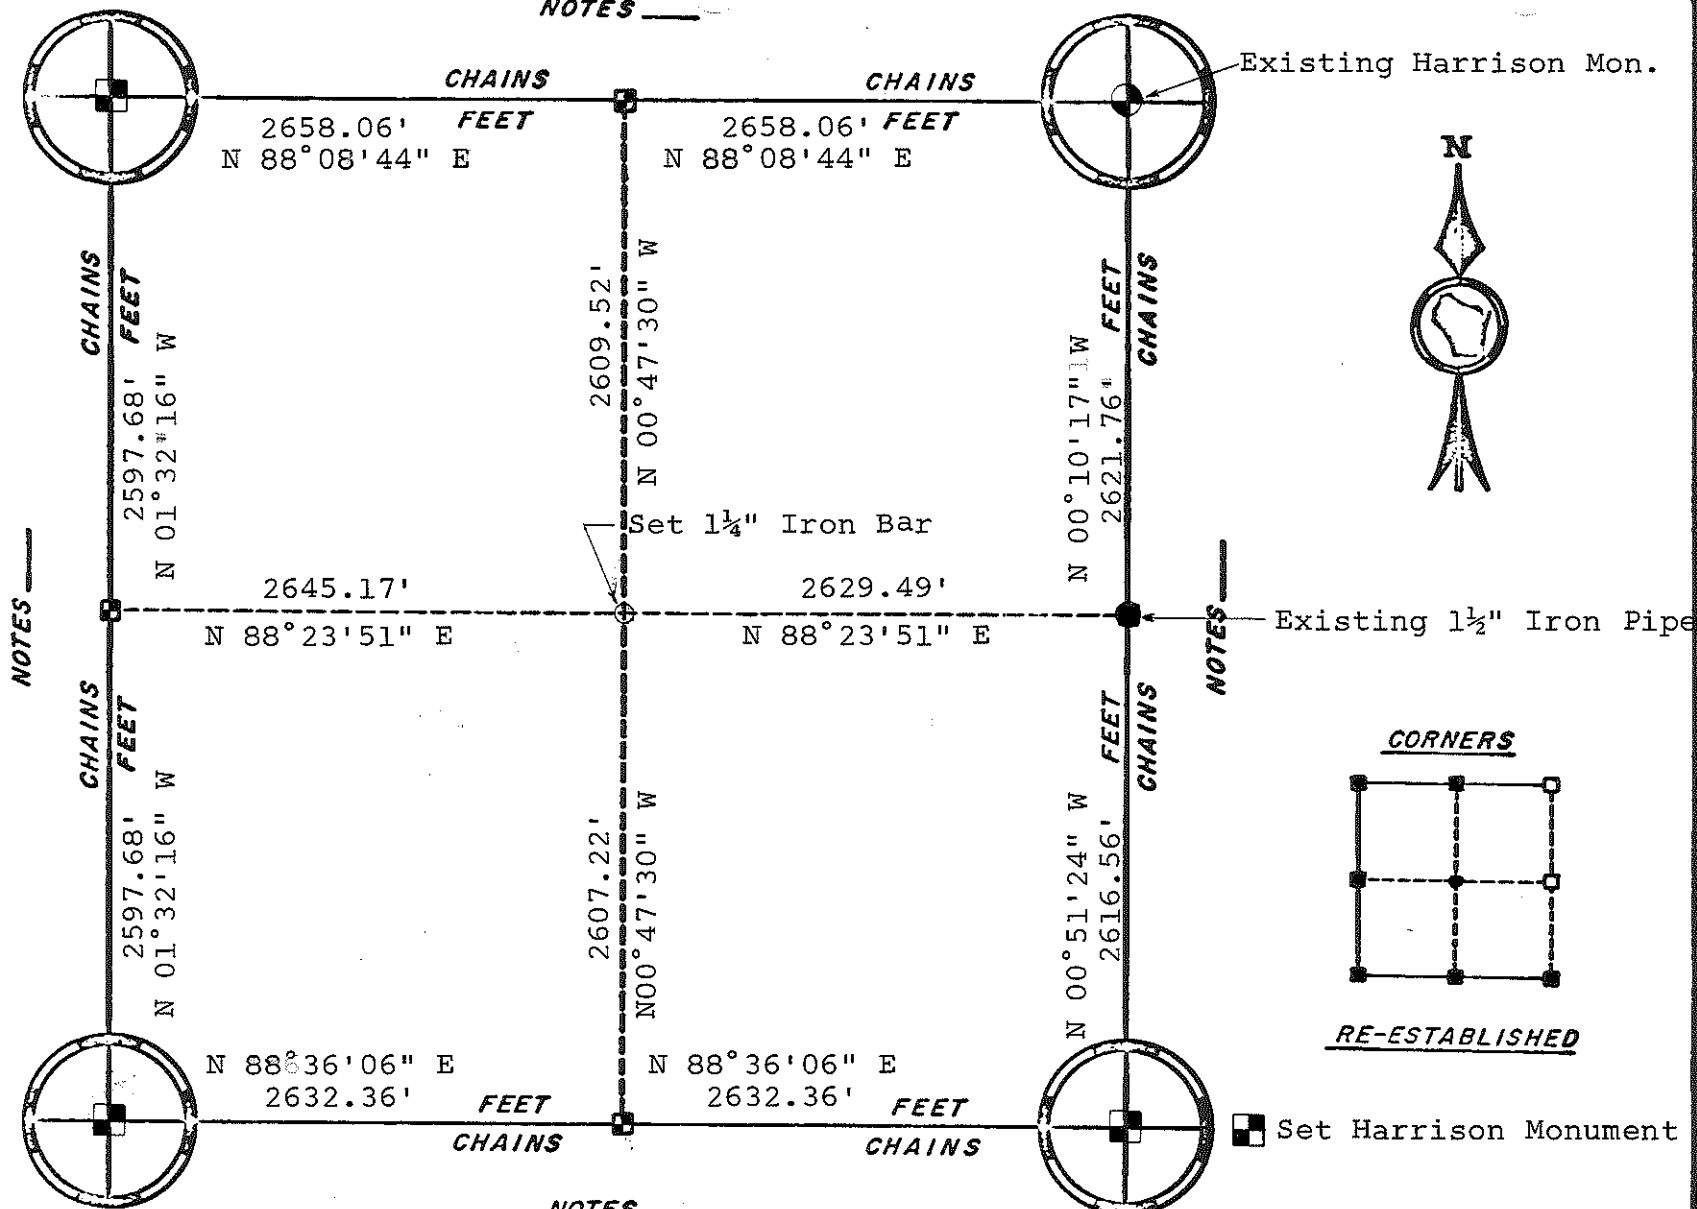

NOTES

NOTES

NOTES


79.92 chs.=5274.72'

ORIGINAL SURVEY DATA

BY \_\_\_\_\_  
DATE \_\_\_\_\_

SURVEYED BY Feddersen Eng.	CONTRACT DATE Dec., 1979- May, 1980	COUNTY MONROE	TOWN <del>VILLAGE CREEK</del> SPARTA	SECTION 28	TOWNSHIP 18 N	RANGE 4 W
-------------------------------	---	------------------	--	---------------	------------------	--------------

NOTES \_\_\_\_\_

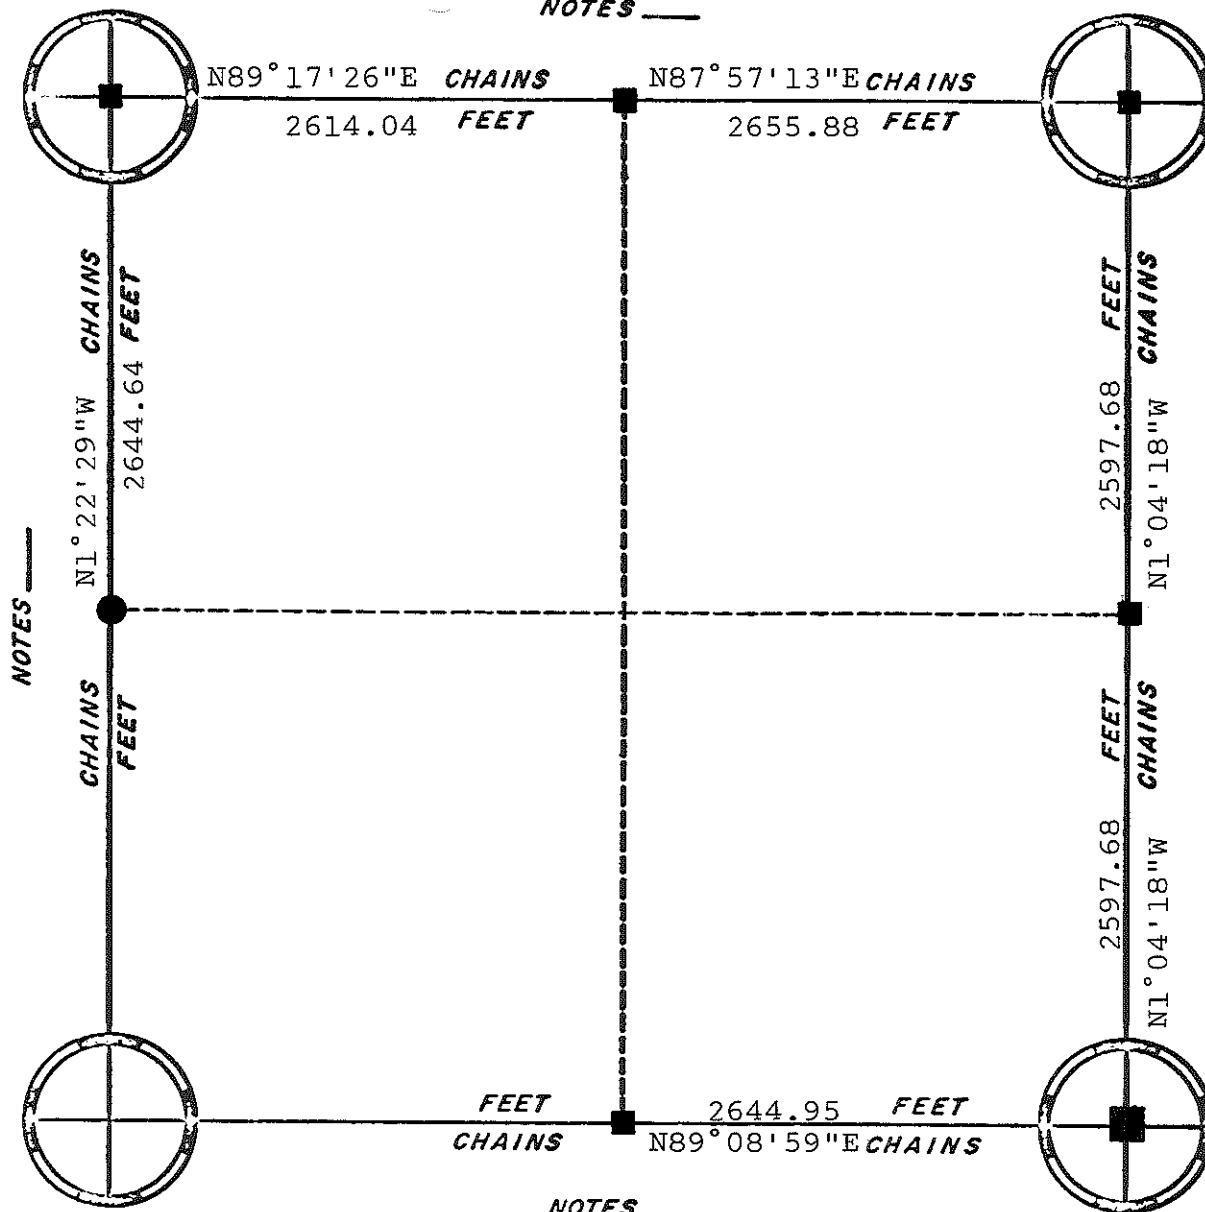

NOTES \_\_\_\_\_

NOTES \_\_\_\_\_


NOTES \_\_\_\_\_



■ = Set Harrison

● = Ex. iron pipe, 1 1/4"

CORNERS

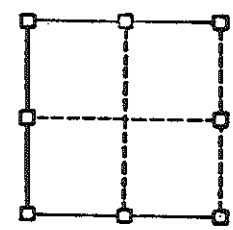

RE-ESTABLISHED


ORIGINAL SURVEY DATA

BY \_\_\_\_\_

DATE \_\_\_\_\_

SURVEYED BY L. A. Feddersen	CONTRACT DATE Dec. 17, 1982	COUNTY MONROE	TOWN <del>VILLAGE CITY</del> Sparta	SECTION 29	TOWNSHIP 18N	RANGE 4W
--------------------------------	--------------------------------	------------------	---	---------------	-----------------	-------------

NOTES \_\_\_\_\_

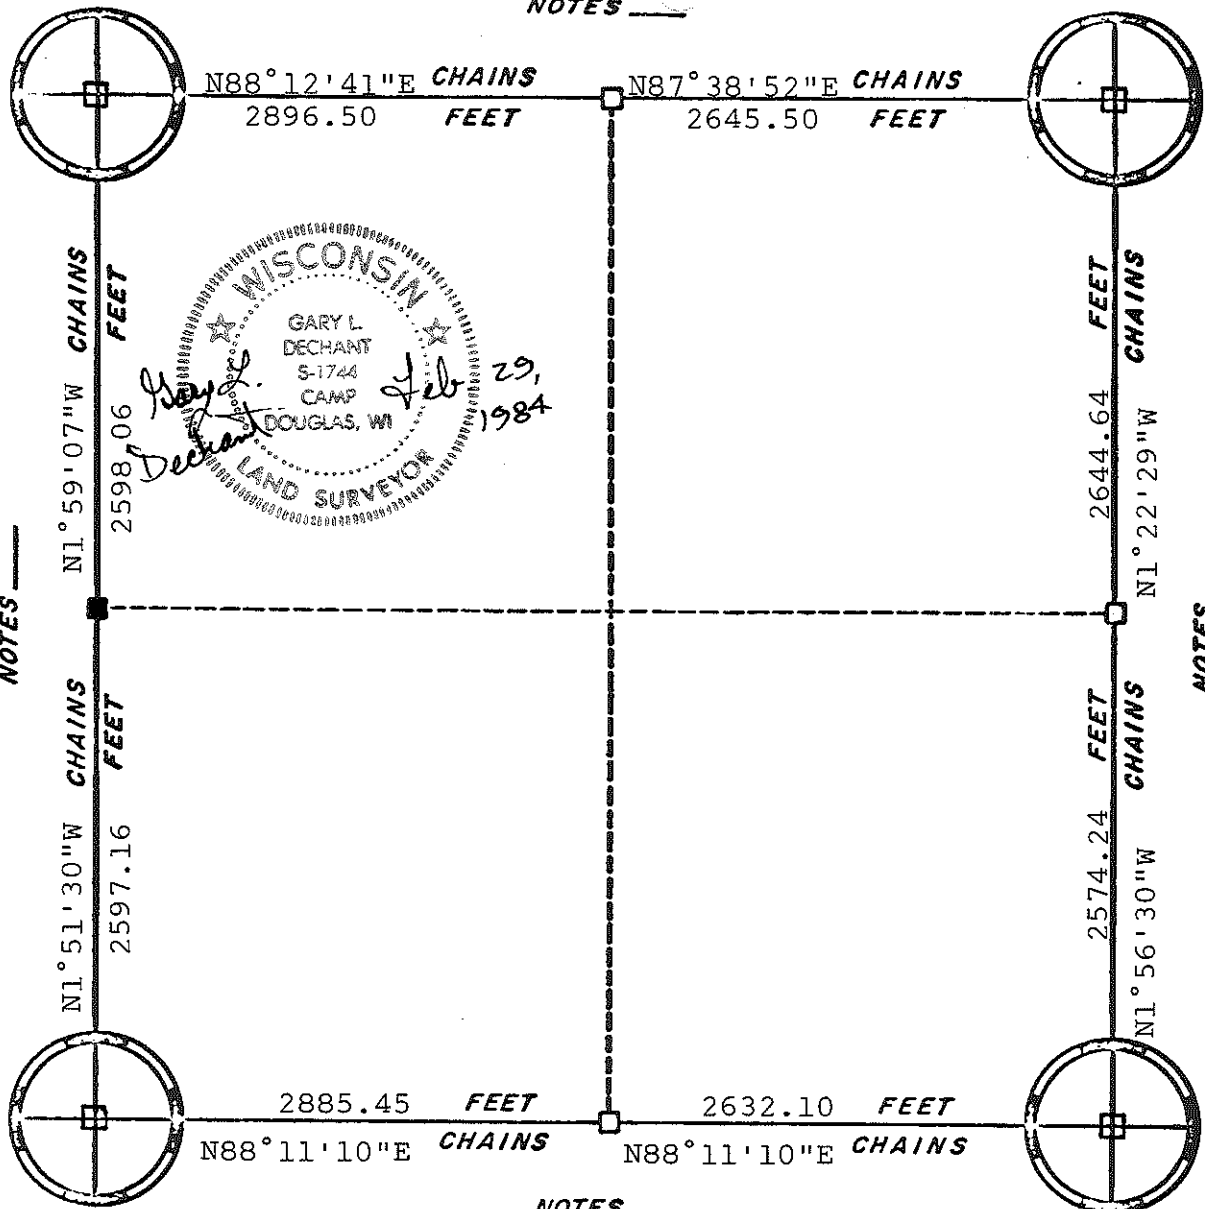


WISCONSIN  
 GARY L. DECHANT  
 S-1744  
 CAMP DOUGLAS, WI  
 Feb 29, 1984  
 LAND SURVEYOR



□ = Harrison Monument  
 ■ = Stone (+)

CORNERS

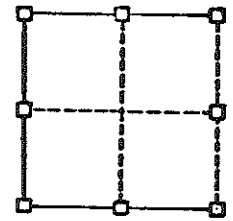

RE-ESTABLISHED

NOTES \_\_\_\_\_

NOTES \_\_\_\_\_

NOTES \_\_\_\_\_

ORIGINAL SURVEY DATA

BY \_\_\_\_\_  
 DATE \_\_\_\_\_

SURVEYED BY L. A. Feddersen G. L. Dechant	CONTRACT DATE Feb. 29, 1984	COUNTY MONROE	TOWN-VILLAGE-CITY Sparta	SECTION 30	TOWNSHIP 18N	RANGE 4W
---	--------------------------------	---------------	-----------------------------	---------------	-----------------	-------------