


PAI —


NOTES —

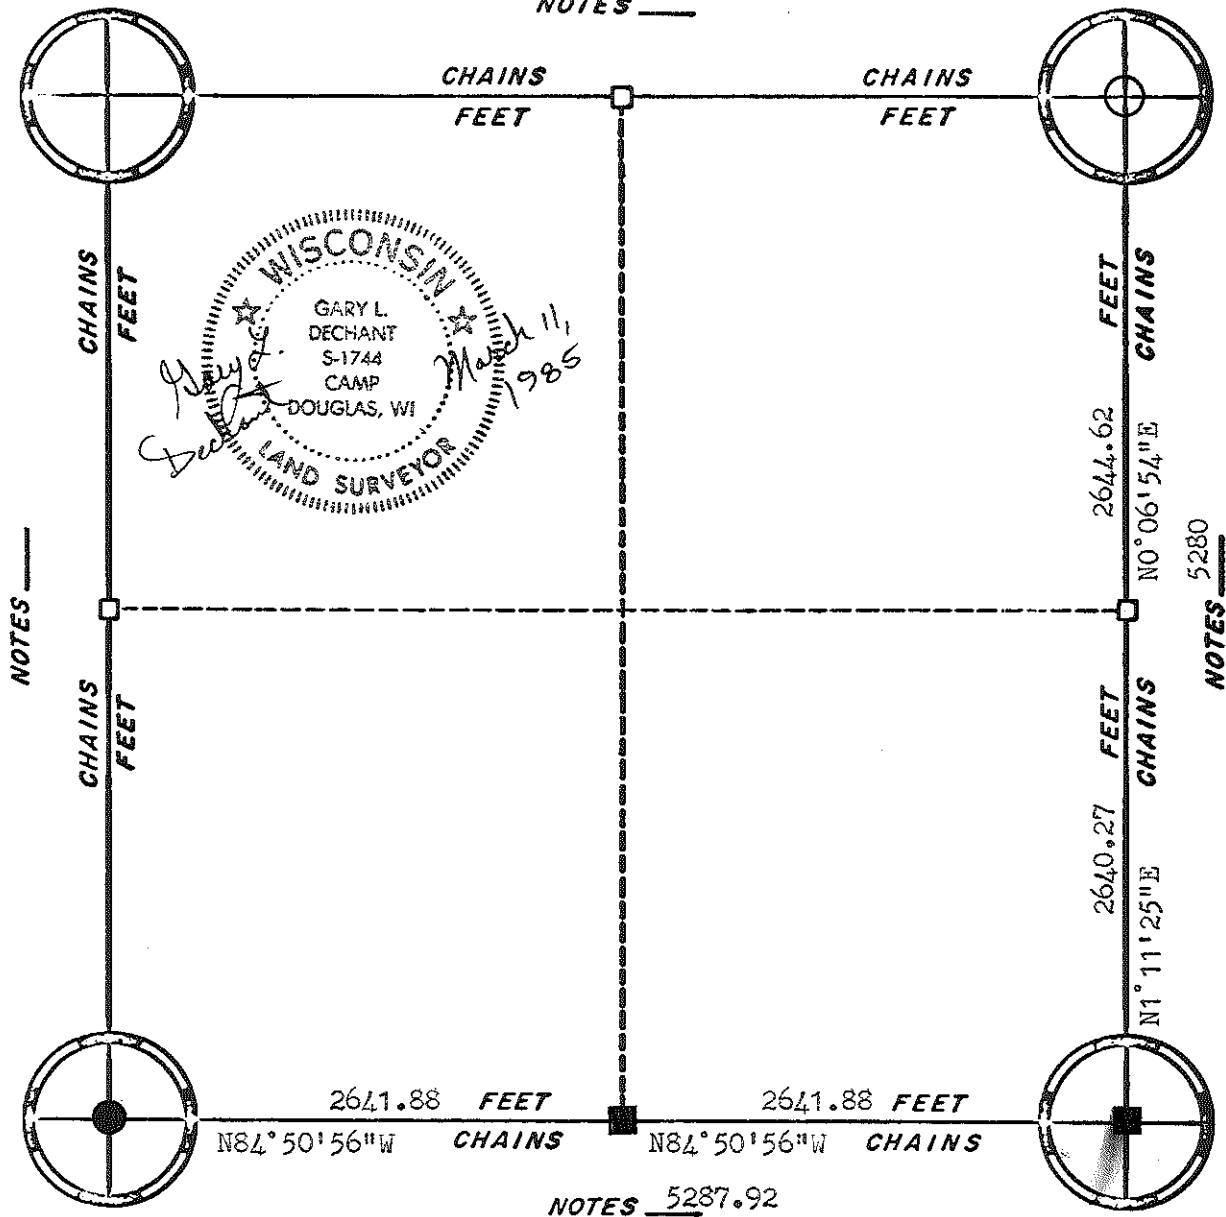

NOTES —

NOTES —

CORNERS

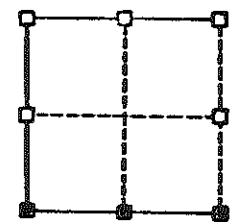

RE-ESTABLISHED

- = 2"x8" iron pipe
- = Harrison Monument
- = 1 1/2" iron pipe


BY

DATE

ORIGINAL SURVEY DATA

SURVEYED BY	CONTRACT DATE	COUNTY MONROE	TOWN-VILLAGE-CITY	SECTION	TOWNSHIP	RANGE
G. L. Dechant	March 7, 1985		Scott	10	19N	1E

NOTES 5280'

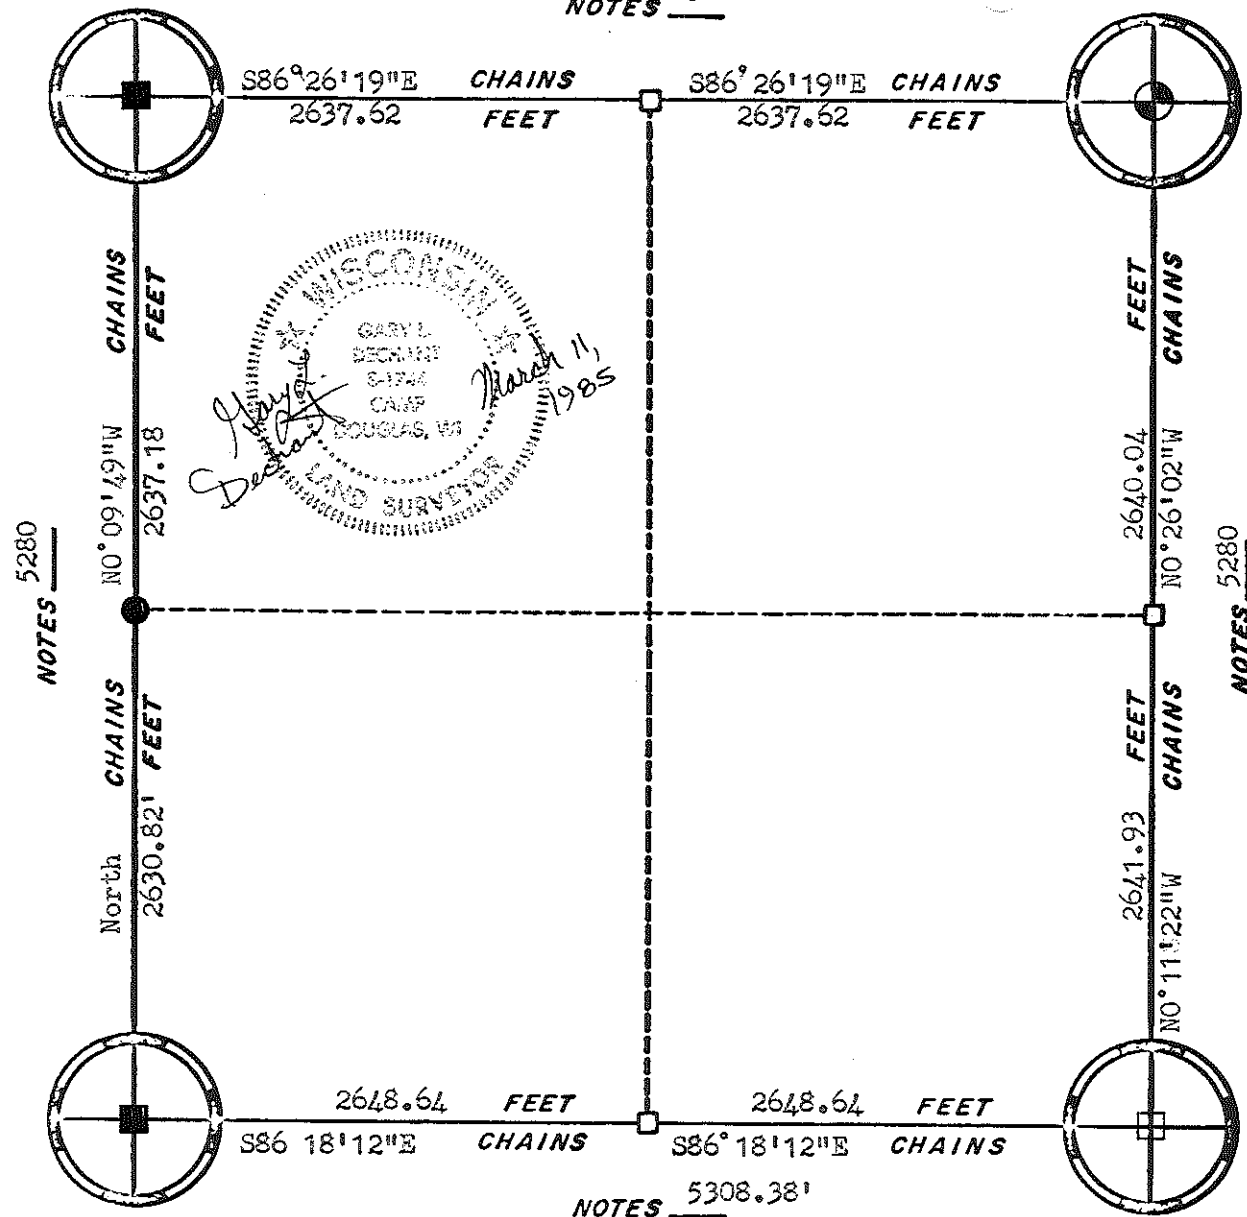


WISCONSIN  
 GARY L. DECHANT  
 6-1744  
 CAMP  
 COUGAS, WI  
 LAND SURVEYOR  
 March 11, 1985  
 Dechant



● = 1 1/4" round iron bar

CORNERS

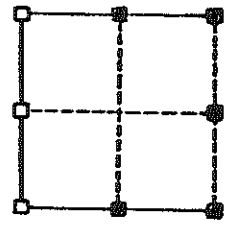

RE-ESTABLISHED

- = Harrison Monument
- ◐ = 2"x8' iron pipe
- = Stone


NOTES 5308.38'

ORIGINAL SURVEY DATA


BY \_\_\_\_\_  
 DATE \_\_\_\_\_

SURVEYED BY G. L. Dechant	CONTRACT DATE March 7, 1985	COUNTY MONROE ██████████	TOWN-VILLAGE-CITY Scott	SECTION 16	TOWNSHIP 19N	RANGE 1E
------------------------------	--------------------------------	-----------------------------	----------------------------	---------------	-----------------	-------------

NOTES

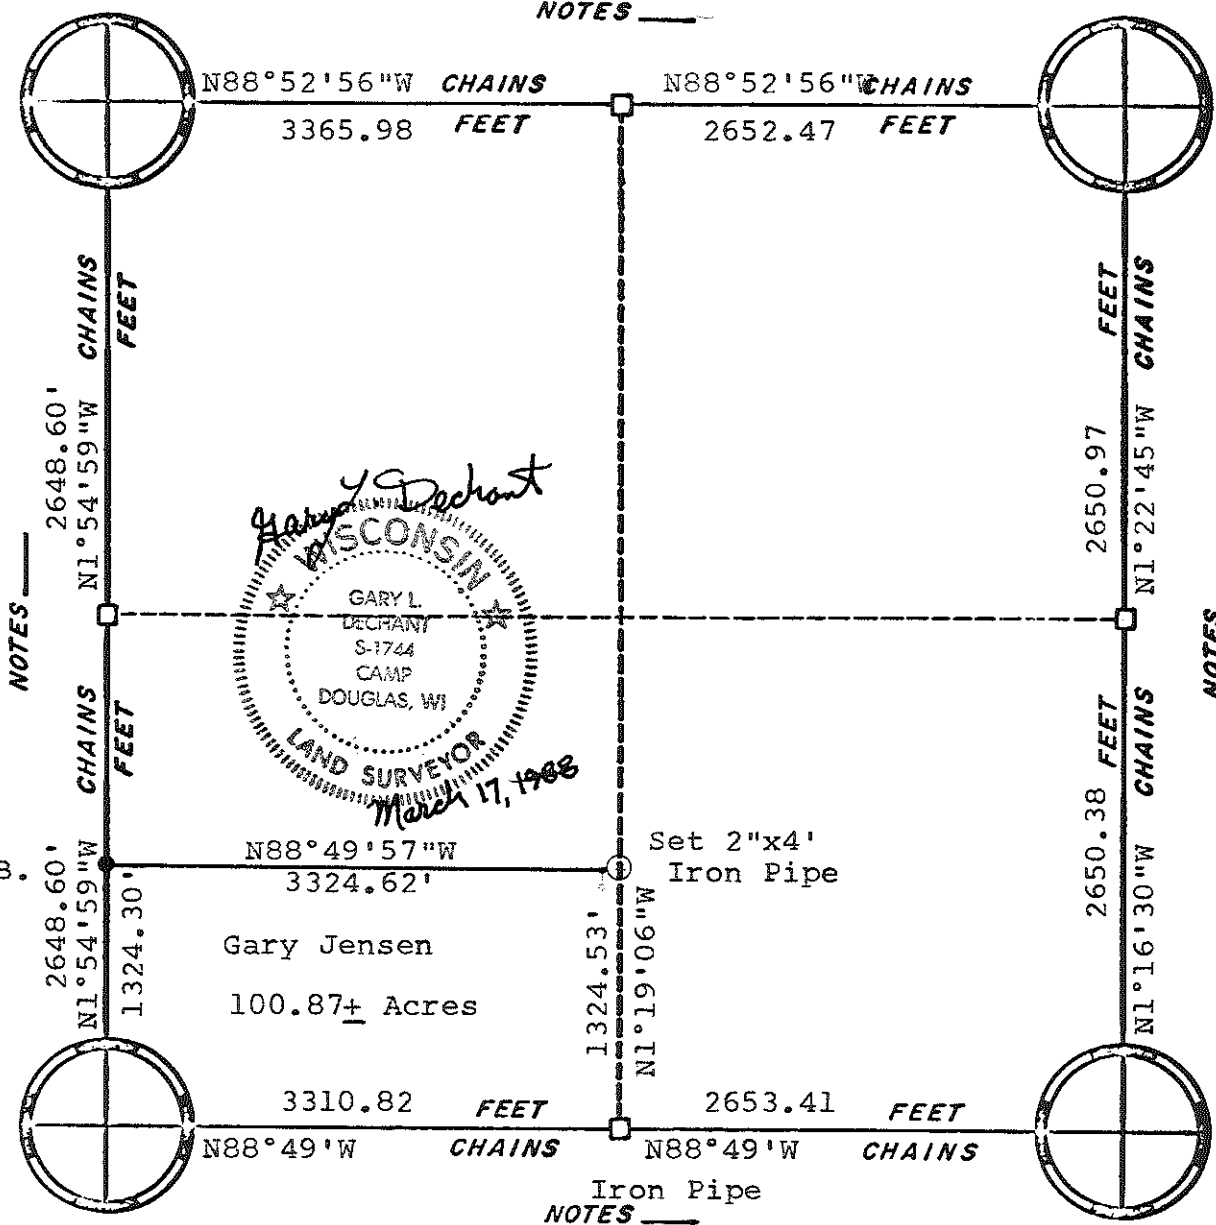

*Gary L. Dechant*  
 WISCONSIN  
 GARY L. DECHANT  
 S-1744  
 CAMP  
 DOUGLAS, WI  
 LAND SURVEYOR  
 March 17, 1988

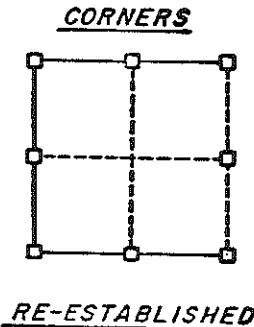

3/4" I.B.

Gary Jensen  
 100.87+ Acres

Set 2"x4'  
 Iron Pipe

Harrison

Iron Pipe  
 NOTES

**ORIGINAL SURVEY DATA**

BY \_\_\_\_\_  
 DATE \_\_\_\_\_

SURVEYED BY G.L. Dechant	CONTRACT DATE March 17, 1988	COUNTY MONROE [REDACTED]	TOWN-VILLAGE-CITY Scott	SECTION 19	TOWNSHIP 19N	RANGE 1E
-----------------------------	---------------------------------	-----------------------------	----------------------------	---------------	-----------------	-------------

# SECTION SUMMARY

Section 31, T19N-R1E

