

#88


# U.S. Public Land Survey Monument Record

Corner ID: S1/4 Sec. 21, T19N-R1E

41901210020

Type of Monument: Set Cast Iron TCP in concrete. Set survey sign 1' east.

### Sec. 21, T19N-R1E

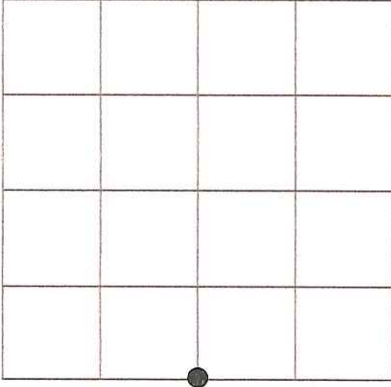

### County Coordinates:

Witnesses: Zachariah P. Dechant  
Gary L. Dechant

### CERTIFICATE:

I, Gary L. Dechant, S-1744, do hereby certify that the corner location was determined under my direction and control as per Chapter AE-7 of the Wisconsin Administrative Code to the best of my knowledge and belief.

April; 21, 2015

### Basis For Monument Location:

(Show info such as history, evidence, testimony, found or method of relocation)

Original Survey performed by George Cole in 1851..

No known surveys since 1851.

Lands in Section 21 were once privately owned. All lands in Section 21 now owned by the USA Government. Set corner on line with pieces of east-west fencing which also lined up with the projected centerline of Buckley Avenue and at prorated distances between the SW corner of Section 21 and the SE corner of Section 23.

