



# U.S. Public Land Survey Monument Record

Corner ID: SE Sec. 22, T19N-R1E

41901220000

Type of Monument: Set 1 1/4" x 5' Iron Pipe

Sec. 22, T19N-R1E

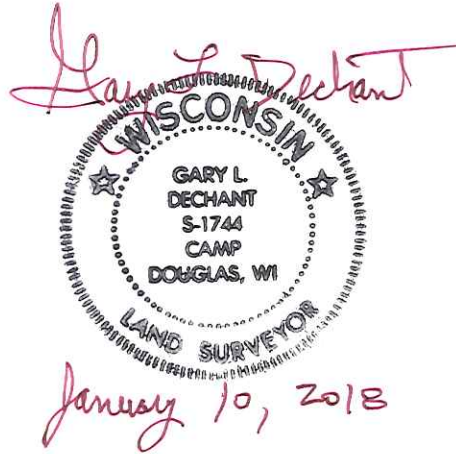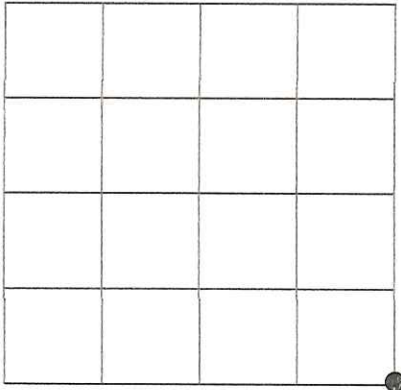

Field date: 1-09-2018

Witnesses: Zachariah P. Dechant  
Gary L. Dechant

I do hereby certify that I have complied with AE 7 of the Wisconsin Administrative Code to best of my knowledge and belief.

*Gary L. Dechant*

### Basis For Monument Location:

(Show info such as history, evidence, testimony, found or method of relocation)

George Cole, Deputy Surveyor, performed the Original Government Survey in 1851.

No known recorded surveys since the original government survey.

Found no traces of original corner. Set by double proportionate measurement.

○=Set 3/4"x24" round iron bar

