

U.S. Public Land Survey Monument Record


107

Corner ID: SE Sec. 28, T19N-R1E

41901280000

Type of Monument: Set 3/4"x4' steel shaft in center line vacated road

Sec. 28, T19N-R1E

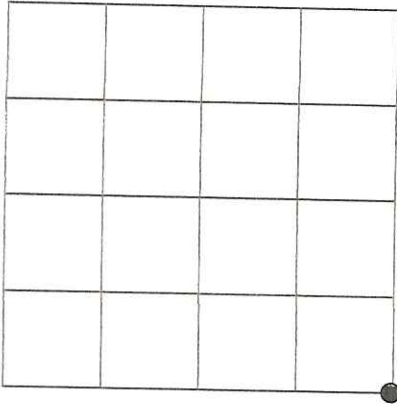

Gary L. Dechant

January 5, 2018

I do hereby certify that I have complied with AE 7 of the Wisconsin Administrative Code to best of my knowledge and belief.

Witnesses: Zachariah P. Dechant
 Gary L. Dechant

Gary L. Dechant
 1-5-2018

Basis For Monument Location:

(Show info such as history, evidence, testimony, found or method of relocation)

Original Government Survey performed by Deputy Surveyor George Cole and crew, November 1851.

Old Town Road records state that a survey was performed to located Town Road on the South line of Section 27.

Set corner in center line of Old Town Road, (now vacated) and at prorated distance from existing SE corner of Section 27 and existing SE corner of Section 29.

