

#108


U.S. Public Land Survey Monument Record

Corner ID: S1/4 Sec. 28, T19N-R1E

41901280020

Type of Monument: Existing 1" square iron bar with 1/4" square top

Sec. 28, T19N-R1E

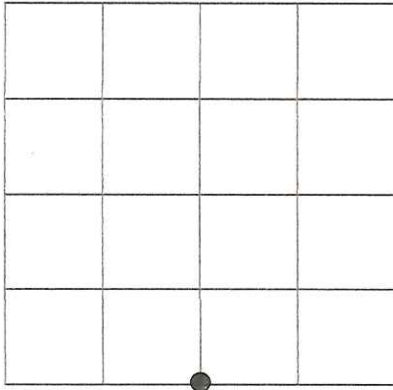

I do hereby certify that I have complied with AE 7 of the Wisconsin Administrative Code to best of my knowledge and belief.

Witnesses: Zachariah P. Dechant
Gary L. Dechant

Gary L. Dechant
1-4-2018

Basis For Monument Location:

(Show info such as history, evidence, testimony, found or method of relocation)

Original Government Survey performed by Deputy Surveyor George Cole and crew, November 1851.

No known surveys since the original government survey.

First search found nothing. Went to set corner by single proportionate measurement, but found unrecorded square iron bar at remnants of buried fencing. This area was once privately owned before it became a USA conservation area which would explain the existing fencing. Have no history of the origin of the square iron bar, but accepted it as the corner as it closely fits computed single proportionate measurement location within a few feet.

O = SET 3/4" x 24" ROUND IRON BAR, DOWN 6"

