

#62


U.S. Public Land Survey Monument Record

Corner ID: S1/4 Sec. 13, T19N-R1E

41901130020

Type of Monument: Set 1.25"x8' round iron bar

Sec. 13, T19N-R1E

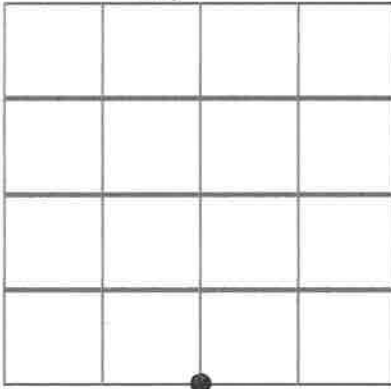

March 25, 2019

County Coordinates:

441044.1774

754865.6492

Witnesses: AL HOFF
Zachariah P. Dechant
Gary L. Dechant

Basis For Monument Location:

(Show info such as history, evidence, testimony, found or method of relocation)

No known history since the Original Government Survey.

Could not find any evidence of corner. Set by single proportionate measurement.

Set 12" spike on side of tree

Set 1.25"x8" round iron bar, up 2'.
Set survey sign 1' north.

