

67

**U.S. PUBLIC LAND CORNER
MAINTENANCE**

**Corner ID : SE Sec.16, T19N-R1E
41901160000**

<u>DATE</u>	<u>CREW</u>	<u>MONUMENT TYPE -----</u>
March 19, 2015	Zachariah P. Dechant Gary L. Dechant	Harrison intact in small mound. Shallow pits north & south. Set sign 2' south.

References:

	<u>Bearing</u>	<u>Distance</u>
1) Set 3/4"x24" round iron bar, 5' south of 14" White Pine	N11W	32.38'
2) Set 3/4"x24" round iron bar, 3' west of 6" White Pine	S83E	23.71'
3) Set 3/4"x24" round iron bar, 4' NW of 12" White Pine	South	34.94'
4) Set 3/4"x24" round iron bar, 4' NW of 10" White Pine (BT)	S75W	18.06'

Gary L. Dechant

October 29, 2015

4190160000

See Reverse Side For Maintenance

I, GARY L. DECHANT, do hereby certify that on the 23 day of FEBRUARY 1985, I found (evidence) (~~no evidence~~) of the SE corner of SECTION 16, T 19 N, R 1E Fourth Principal Meridian, and I re-established said corner according to the Wisconsin Statutes as shown and described hereon.

Dated this 3 day of MARCH 1985.

Gary L. Dechant
REGISTERED LAND SURVEYOR, S-1744
Title

History of corner establishment since Original Government Survey

FRED HOLDEN WAS HERE IN SEPT. OF 1903.

Description of corner evidence found:



FOUND ORIGINAL BEARING TREE STUMP. RE-SET CORNER BY DISTANCE AND BEARING GIVEN IN ORIG. SURVEY NOTES. BROKE PIECES OFF, MOSTLY ROTTED BUT DID FIND INNER PIECE WITH GRAIN PATTERN TO IDENTIFY IT. FITS EXTREMELY BOTH NORTH TO E 1/4 SEC 16 & SW COR. OF SEC. 16.

Description of corner and witness monuments, references and accessories used to perpetuate the original or re-established location of this corner:

Witnesses to corner location:

DANNY L. DRAEGER D/D

GARY L. DECHANT D/A

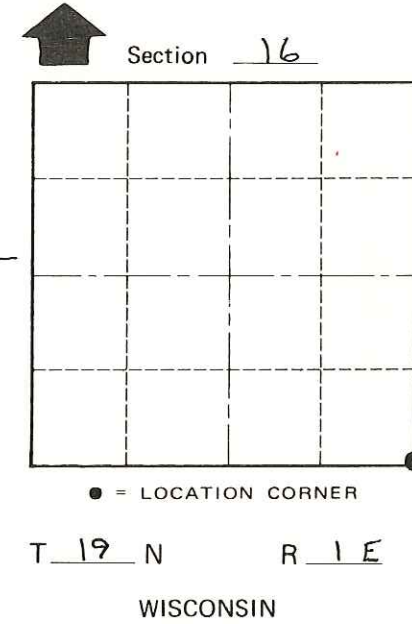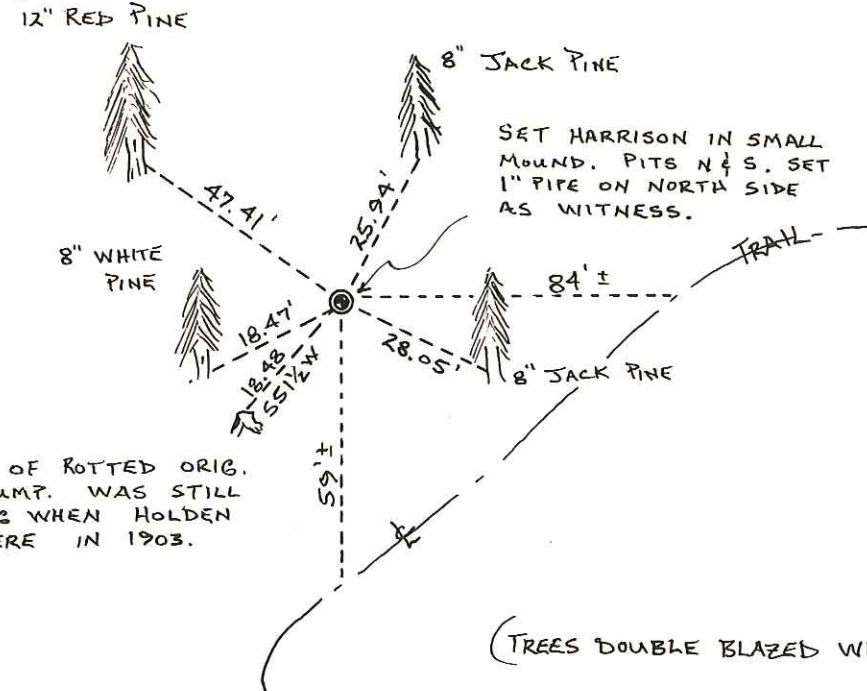

REMAINS OF ROTTED ORIG. B.T. STUMP. WAS STILL STANDING WHEN HOLDEN WAS HERE IN 1903.

(TREES DOUBLE BLAZED WITH NAILS SET)

SURVEY CONTROL ORDER

Horizontal	_____
Vertical	_____

WISCONSIN COORDINATE SYSTEM

Corner	East (X)	North (Y)	Elevation (Z)	Zone
Control Sta. Name				

City, Village or Town SCOTT
County of MONROE

COUNTY SURVEYOR FORM NO. 1