



# U.S. Public Land Survey Monument Record

Corner ID: S1/4 Sec. 22, T19N-R1E

41901220020

Type of Monument: Set 1-1/4"x5' iron pipe, up 10"

Sec. 22, T19N-R1E

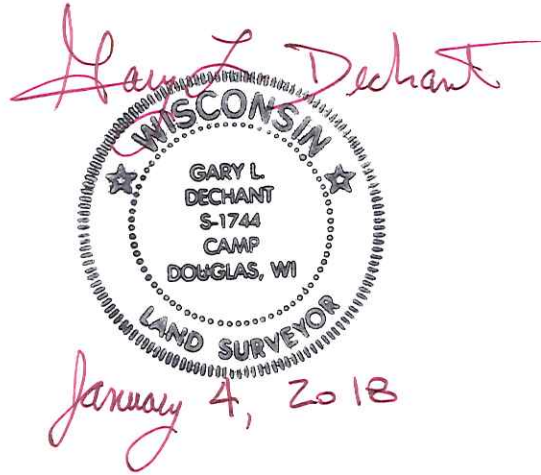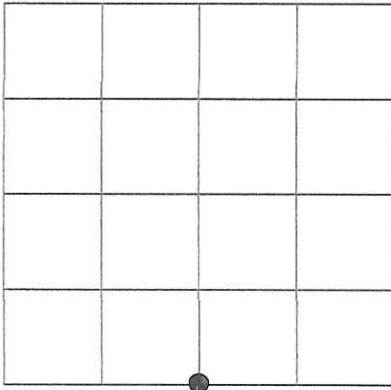

I do hereby certify that I have complied with AE 7 of the Wisconsin Administrative Code to best of my knowledge and belief.

Witnesses: Zachariah P. Dechant  
Gary L. Dechant

*Gary L. Dechant Jan. 4, 2018*

### Basis For Monument Location:

(Show info such as history, evidence, testimony, found or method of relocation)

Original Government Survey performed by Deputy Surveyor George Cole and crew, November 1851.

No known surveys since the original government survey.

Found no evidence of corner. Set by single proportionate measurement.

