

41



U.S. Public Land Survey Monument Record

Corner ID: SE Sec. 12, T19N-R1E

41901120000

Type of Monument: Set 1.25"x8" round iron bar

Sec. 12, T19N-R1E

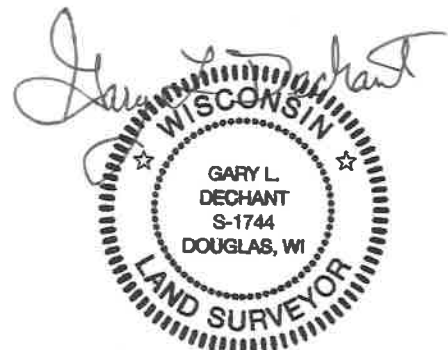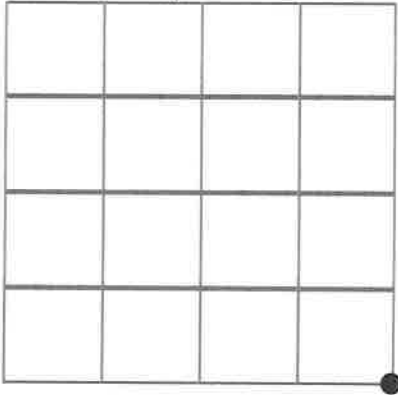

March 25, 2019

County Coordinates:

446127.0423
757437.1320 1991/2011

Witnesses: Al Hoff
Gary L. Dechant

Basis For Monument Location:

(Show info such as history, evidence, testimony, found or method of relocation)

Original government survey by George Cole in 1851.

Found an unrecorded 2" iron pipe lying flat in swamp, most likely set by S. Kennedy in the 1930's-1940's.
Set 1.25"x8' round iron bar at east end of 2" pipe that fit corners north and south along county line extremely well.

Bearing trees blazed with 40d nail set

Set 1.25"x8' round iron bar,
up 1' in swamp.
Set survey sign 1' north.

