

42


U.S. Public Land Survey Monument Record

Corner ID: S1/4 Sec. 12, T19N-R1E

41901120020

Type of Monument: Existing 1.25" iron pipe

Sec. 12, T19N-R1E

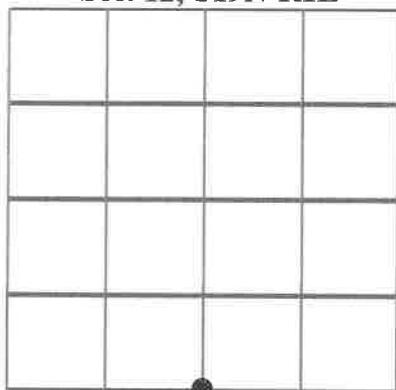

March 25, 2019

County Coordinates:

446326.7954

754812.901 1991/2011

AL HOFF

Witnesses: Zachariah P. Dechant

Gary L. Dechant

Basis For Monument Location:

(Show info such as history, evidence, testimony, found or method of relocation)

No known history since the Original Government Survey.

Found and accepted an unrecorded 1.25" iron pipe. Fits well with other corners and reasonably well with old fence occupation. It's possible this corner may have been set by S. Kennedy, who had done a lot of work in the Town of Scott in the 1930's-1940's.

