

40


U.S. Public Land Survey Monument Record

Corner ID: E1/4 Sec. 12, T19N-R1E

41901122000

Type of Monument: Set 1.25"x8" round iron bar

Sec. 12, T19N-R1E

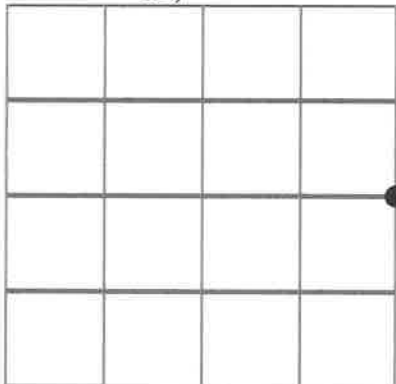

County Coordinates:

448768.8090

757416.7722 1991/2011

Witnesses: Al Hoff

Gary L. Dechant



March 26, 2019

Basis For Monument Location:

(Show info such as history, evidence, testimony, found or method of relocation)

Original government survey by George Cole in 1851.

Could not find any solid evidence of corner. Set by single proportionate measurement.

○=Set 24" section of steel fence post (T-post)

Set 1.25"x8" round iron bar on north side of ditch heading west and 18' west of ditches heading north. Up 2" in soft ground. Set survey sign 3' north.

