

61

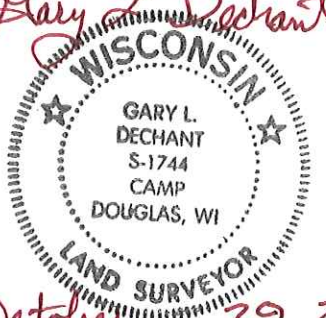
**U.S. PUBLIC LAND CORNER
MAINTENANCE**

**Corner ID : SE Sec.13, T19N-R1E
41901130000**

<u>DATE</u>	<u>CREW</u>	<u>MONUMENT TYPE -----</u>
March 19, 2015	Zachariah P. Dechant Gary L. Dechant	Existing 2" capped stamped iron pipe. No record of it, but believe to have been set by S Kennedy in the 1930's. 245' south of trail.

References:

	<u>Bearing</u>	<u>Distance</u>
1) Set 3/4"x24" iron bar, 3' west of 10" Maple, 3' south of 7" White Pine	N20E	27.45'
2) Set 3/4"x24" iron bar, 5' south of 14" Red Oak (BT)	S83E	24.74'
3) Set 3/4"x24" iron bar, 5' north of 10" White Pine	S12W	24.03'
4) Set 3/4"x24" iron bar, 3' north of 6" White Pine	S69W	25.43'

Gary L. Dechant

October 29, 2015

