

60


U.S. Public Land Survey Monument Record

Corner ID: E1/4 Sec. 13, T19N-R1E

41901132000

Type of Monument: Existing 2" capped iron pipe

Sec. 13, T19N-R1E

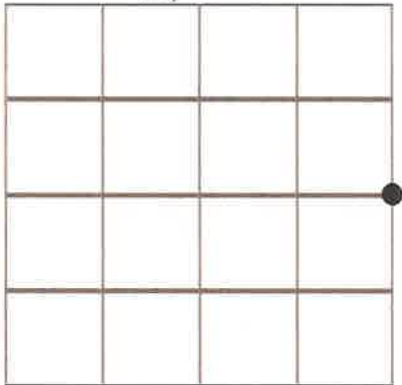

County Coordinates:

443498.1615

757454.4160 1991/2011

AL HOFF

Witnesses: Zachariah P. Dechant

Gary L. Dechant



March 26, 2019

Basis For Monument Location:

(Show info such as history, evidence, testimony, found or method of relocation)

Original government survey by George Cole in 1851.

Found and accepted a 2" capped iron pipe most likely set by S. Kennedy, who had done a lot of work in the Town of Scott in the 1930's-1940's.

Existing 2" capped iron pipe, up 12".
Set survey sign 1' north.
Approx. 550' east of trail.

