

#63


Corner ID: SE Sec. 14, T19N-R1E

U.S. Public Land Survey Monument Record

41901140000

Type of Monument: Set 1-1/4"x5' steel shaft. Set survey sign 1' north.

Sec. 14, T19N-R1E

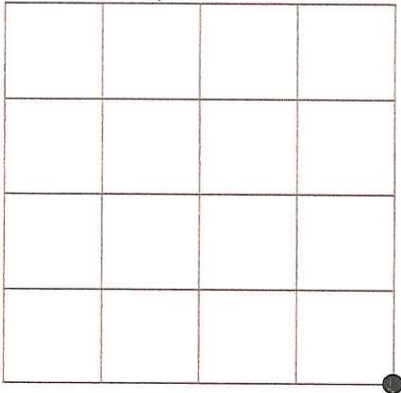

County Coordinates:

Witnesses: Zachariah P. Dechant
Gary L. Dechant

Basis For Monument Location:

(Show info such as history, evidence, testimony, found or method of relocation)

Original Survey performed by George Cole in 1851..


Fred Holden was in Sections 14 and 15 in 1903.

Found no evidence of corner. All surrounding lands owned by the USA Government.
Set by double proportionate mesurement using SW corner of Section 15, E1/4 corner of Section 14, SE corner Section 13, and SE corner of Section 23.

CERTIFICATE:

I, Gary L. Dechant, S-1744, do hereby certify that the corner location was determined under my direction and control as per Chapter AE-7 of the Wisconsin Administrative Code to the best of my knowledge and belief.

April; 21, 2015

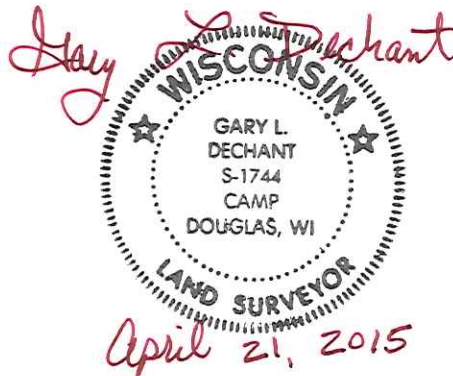

○ = SET 3/4" X 24" ROUND IRON BAR

1

