

#66


U.S. Public Land Survey Monument Record

Corner ID: S1/4 Sec. 15, T19N-R1E

41901150020

Type of Monument: Set 1-1/4"x6' iron pipe. Set survey sign 1' north.

Sec. 15, T19N-R1E

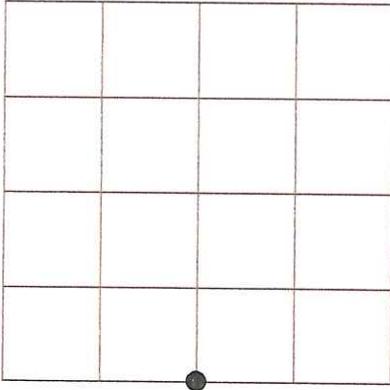

County Coordinates:

CERTIFICATE:

I, Gary L. Dechant, S-1744, do hereby certify that the corner location was determined under my direction and control as per Chapter AE-7 of the Wisconsin Administrative Code to the best of my knowledge and belief.

Witnesses: Zachariah P. Dechant
Gary L. Dechant

April; 21, 2015

Gary L. Dechant

Basis For Monument Location:

(Show info such as history, evidence, testimony, found or method of relocation)

Original Survey performed by George Cole in 1851..

Fred Holden was in Sections 14 and 15 in 1903.

Found no evidence of corner. All surrounding lands owned by the USA Government.
Set by single proportionate measurement.



April 21, 2015

O= SET 3/4"x 24" ROUND IRON BAR

