

31

**U.S. PUBLIC LAND CORNER
MAINTENANCE**

**Corner ID : SE Sec. 6, T19N-R1W
21901060000**

<u>DATE</u>	<u>CREW</u>	<u>MONUMENT TYPE</u>
April 5, 2018	Zachariah P. Dechant Gary L. Dechant	Existing 2-1/2" iron pipe, up 2.5 feet, 30' north of trail, approx. 300' north of railroad. Set new sign 2' north. 8" Maple BT good shape Other BT's gone. Pit 6' SE. Ditch 9' NW.

References:

	<u>Bearing</u>	<u>Distance</u>
1) Set 1/4"x24" iron pipe, down 6", 4' west of 6" White Pine	East	45.00'
2) Set 1/4"x24" iron pipe, down 6", in center line of trail	S12E	51.95'
3) Set 1/4"x24" iron pipe, down 6", in center line of trail	S60W	36.80'
4) Set 1/4"x24" iron pipe, down 6", 4' SE of 5" White Oak	N24W	39.40'



I, Harley A. Sime, do hereby certify that on the 2nd day of May 1980, I found ~~(evidence)~~ (no evidence) of the SE corner of Section 6, T 19 N, R 1 W Fourth Principal Meridian, and I re-established said corner according to the Wisconsin Statutes as shown and described hereon.

History of corner establishment since Original Government Survey
No known recorded history since the original government survey.

Description of corner evidence found:

Set by double proportionate measure. The NE corner of Section 6, W $\frac{1}{4}$ corner of Section 8, SW corner of Section 6, and the SE corner of Section 5 were the four known corners to relocate the SE corner of Section 6 by double proportionate measure.

Dated this 5th day of Jan. 1981.

Approved: HARLEY A. SIME
MONROE CO. SURVEYOR
Title

COUNTY SURVEYOR FORM NO. 1


Description of corner and witness monuments, references and accessories used to perpetuate the original or re-established location of this corner:

Witnesses to corner location:

G. Dechant
T. Tormoen
B. Meyer


Set $2\frac{1}{2}$ " x 7' iron pipe, up $2\frac{1}{2}$ '.

See Reverse Side For Maintenance

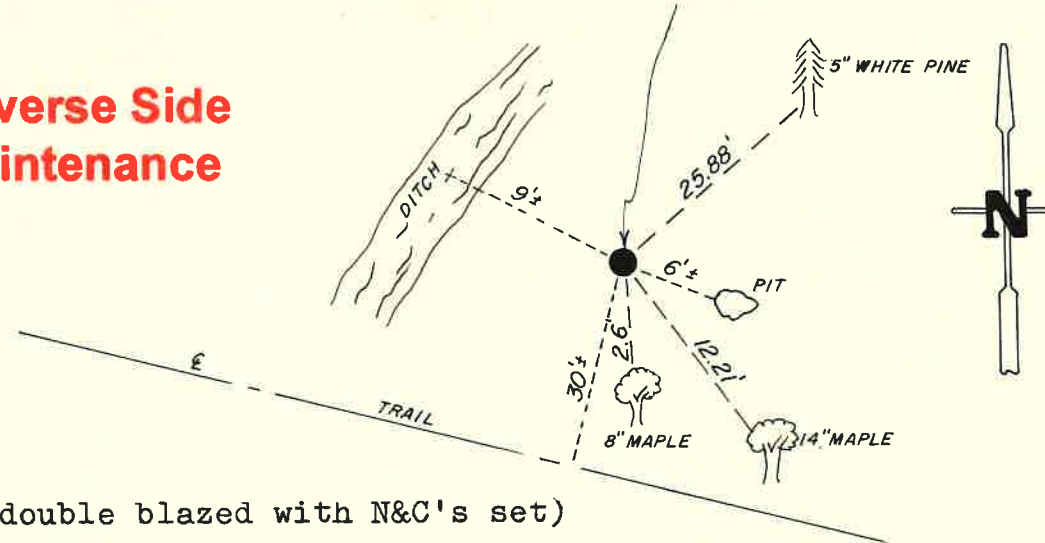

(All trees are double blazed with N&C's set)

SIGN PLACED 10-26-93

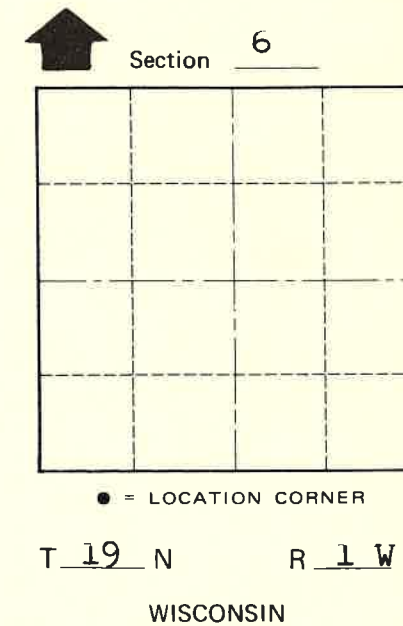

SURVEY CONTROL ORDER

Horizontal _____
Vertical _____

WISCONSIN COORDINATE SYSTEM

Corner	East (X)	North (Y)	Elevation (Z)	Zone
Control Sta. Name				

City, Village or Town Lincoln

County of Monroe