

**U.S. PUBLIC LAND CORNER
MAINTENANCE**

35

**Corner ID: W1/4 Sec.8, T19N-R1W
21901072000**

<u>DATE</u>	<u>CREW</u>	<u>MONUMENT INFO</u>		
August 12, 2020	Zachariah P. Dechant Gary L. Dechant	Found Harrison intact, railroad tie 1' west, sign 1' north, steel post 1'E, steel post 1.5' SE		
		<u>Compass Bearing</u>	<u>Distance</u>	
1) Set 2' section of steel T post, down 6",		N56E	20.10'	
2) Set 2' section of T' post, down 6", 4' NW of 14" White Pine		S64E	20.85'	
3) Set 2' section of T post, down 6", 4' NE of 6" White Pine center of ridge		S28W	35.20'	
4) Set 2' section of T post, down 6", 4' SE of 4" White Pine		N20W	25.44'	



I, Harley A. Sime, do hereby certify that on the 15th day of June 1973, I found ~~evidence~~ (no evidence) of the West 1/4 corner of Section 8, T 19 N, R 1 W Fourth Principal Meridian, and I re-established said corner according to the Wisconsin Statutes as shown and described hereon.

History of original corner establishment:

See Reverse Side For Maintenance

Description of corner evidence found:

Dated this 1st day of March 1976.

The corner was set by projecting the bearing along the West line of the NW $\frac{1}{4}$ of Section 17 and intersecting it with the existing East-West fence.

County Surveyor
Title



**Approved: HARLEY A. SIME
MONROE CO. SURVEYOR**

Description of corner and witness monuments, references and accessories used to perpetuate the original or re-established location of this corner:

Set a Harrison marker in the fence, up 4".

Witnesses to corner location:

D. Marten-Crew Chief

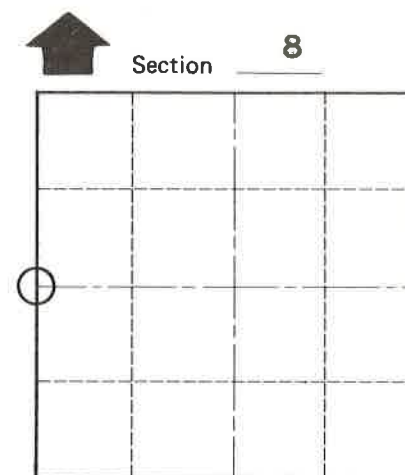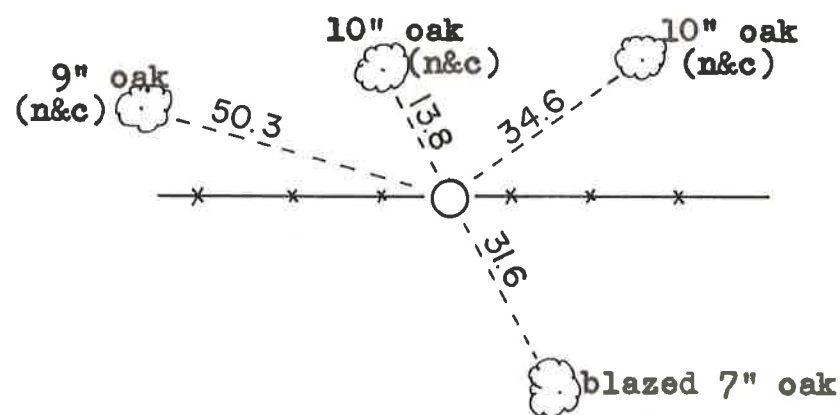

O = LOCATION CORNER
T 19 N R 1 W
WISCONSIN

COUNTY SURVEYOR FORM NO. 1

SURVEY CONTROL ORDER

Horizontal	<u>Gary L. Dechant</u>			
Vertical	<u>10-5-2015</u>			
Corner	East (X) <u>698627.473</u>	North (Y) <u>450369.297</u>	Elevation (Z)	Zone
Control Sta. Name				

MONROE COUNTY
WISCONSIN COORDINATE SYSTEM

City, Village or Town Lincoln
County of Monroe