

21901022000

I, Harley A. Sime, do hereby certify that on the 25th day of January 1982, I found ~~(evidence)~~ (no evidence) of the E $\frac{1}{4}$ corner of Section 2, T 19N, R 1 W Fourth Principal Meridian, and I re-established said corner according to the Wisconsin Statutes as shown and described hereon.

Dated this 27th day of Jan. 1982.

Harley A. Sime, R.L.S. 355

County Surveyor
Title

History of corner establishment since Original Government Survey

We were here in July of 1980 and set an iron bar ($\frac{3}{4}$ " round) in the area of the E $\frac{1}{4}$ corner, but could not find it.

Description of corner evidence found:

We ran a random line between the NE corner and the SE corner of Section 2 for a distance check and found it to check very well. Set corner on line between the NE and SE corners of Section 2 and set it by proportioning to the original government notes.

Description of corner and witness monuments, references and accessories used to perpetuate the original or re-established location of this corner:

Witnesses to corner location:



G. Dechant

B. Meyer

**Approved: HARLEY A. SIME
MONROE CO. SURVEYOR**



Set $2\frac{1}{2}$ "x7' iron pipe, up 3'+.

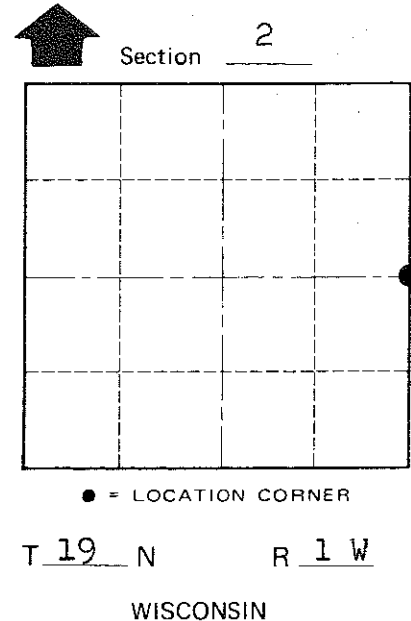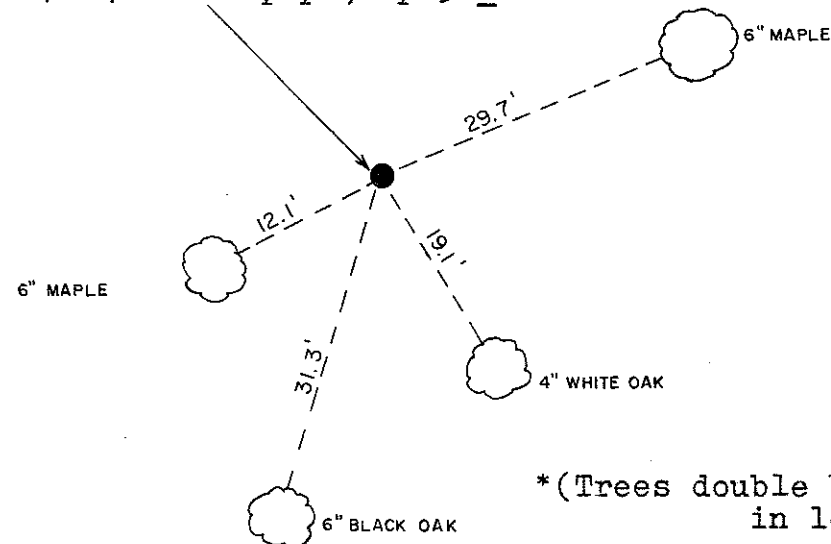

(Trees double blazed with nail set in lower blaze)

SURVEY CONTROL ORDER

Horizontal	_____
Vertical	_____

WISCONSIN COORDINATE SYSTEM

Corner	East (X)	North (Y)	Elevation (Z)	Zone
Control Sta. Name				

~~City, Village or Town~~ Lincoln
County of Monroe

COUNTY SURVEYOR FORM NO. 1