

# 18


**U.S. PUBLIC LAND CORNER  
MAINTENANCE**

**Corner ID : E1/4 Sec. 3, T19N-R1W  
21901032000**

DATE	CREW	MONUMENT TYPE -----
April 8, 2016	Zachariah P. Dechant Gary L. Dechant	Found Harrison top broke off. Down 10" On line with fence west. At north end of Atom Road. Set new sign 2' west

References:

	<u>Bearing</u>	<u>Distance</u>
1) Set 3/4"x24" round iron bar, down 6" 4' east of 12" Jack Pine (BT)	N2E	50.89
2) Set 3/4" x 24" round iron bar, down 6", 6' south of 14" White Pine	S38E	52.58'
3) Set 3/4" x24" round iron bar, down 6", 3' SW of two 10" Jack Pines	S72W	69.22'
4) Set 3/4" x 24" round iron bar, down 6", 3' north of power pole anchor & 4' east of 6" White Pine	N88W	42.58'

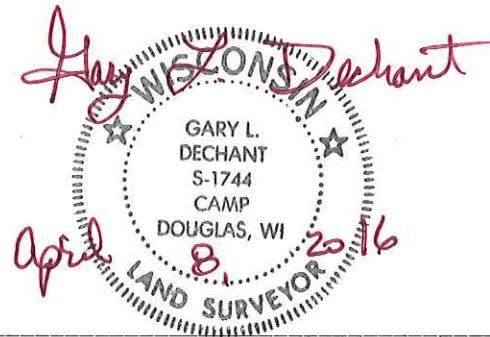

I, William C. Jung, do hereby certify that on the 26th day of March 1979, I found (evidence) (no evidence) of the EA corner of Section 3, T 19 N, R 1 W Fourth Principal Meridian, and I re-established said corner according to the Wisconsin Statutes as shown and described hereon.

History of corner establishment since Original Government Survey

No known recorded history since the original government survey.

Description of corner evidence found:

Set on line and equidistant between the NE & SE corners of Sec. 3.

Dated this 28th day of March 1979.

William C. Jung, R.L.S. 1323

County Surveyor's Office

Title

*William C. Jung*

COUNTY SURVEYOR FORM NO. 1


Description of corner and witness monuments, references and accessories used to perpetuate the original or re-established location of this corner:

Set Harrison Monument.

Witnesses to corner location:

G. Dechant

C. Pietz

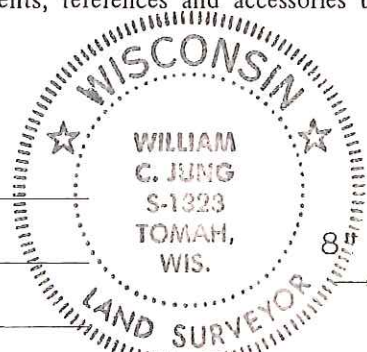

4" Jack Pine

8" Jack Pine


6" Jack Pine

Harrison

5" White Pine

(All trees with N&C's set but did not blaze)

See Reverse Side For Maintenance

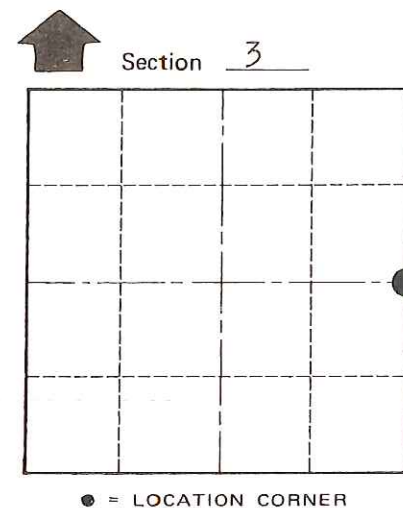

T 19 N R 1 W

WISCONSIN

Approved by: Harley A. Sime  
County Surveyor

SURVEY CONTROL ORDER

Horizontal \_\_\_\_\_  
Vertical \_\_\_\_\_

WISCONSIN COORDINATE SYSTEM

Corner	East (X)	North (Y)	Elevation (Z)	Zone
Control Sta. Name				

City, Village or Town Lincoln

County of Monroe