

CERTIFICATE

I, Bryan H. Meyer, do hereby certify that on the 16th day of February, 19 89, I found ~~(no evidence)~~ (no evidence) of the East 1/4 corner of Section 34, T 19 N, R 1 W Fourth Principal Meridian, and I re-established said corner according to the Wisconsin Statutes as shown and described hereon.

Dated this 16th day of February, 19 89.

Bryan H. Meyer
Deputy County Surveyor
Title

CERTIFIED LAND CORNER

History of corner establishment since Original Government Survey

Nothing Recorded.

Description of corner evidence found:

I re-established this corner on line and equi-distant between the Northeast and Southeast corners of Section 34.

No. 118

21901342000



H. A. Sime and Associates
P. O. Box 705, Tomah, Wisconsin
Phone: (608)-372-5392



COUNTY SURVEYOR FORM NO. 1

Description of corner and witness monuments, references and accessories used to perpetuate the original or re-established location of this corner:

Crew: Meyer, Forsythe
Date: February 16, 1989
Weather: Cloudy, 10°±
Witnesses to corner location:

Bryan H. Meyer

Brian Forsythe

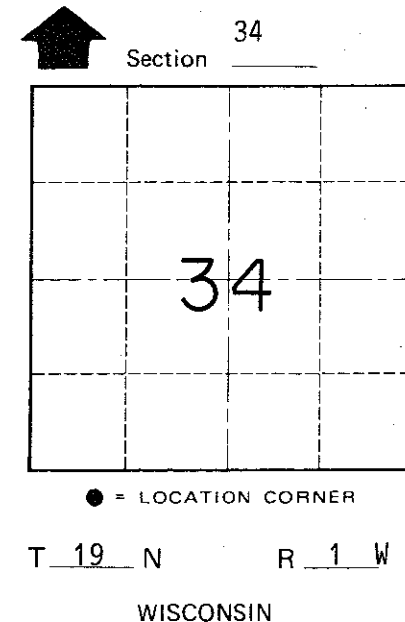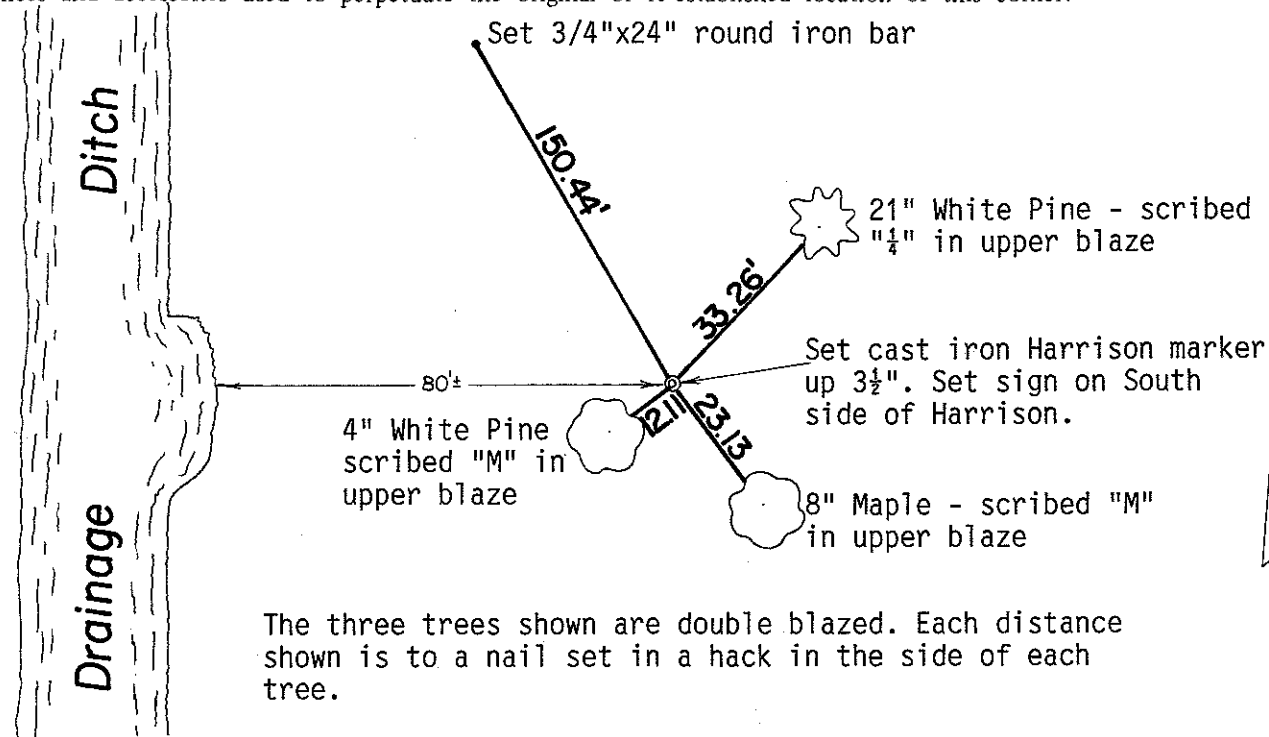

The three trees shown are double blazed. Each distance shown is to a nail set in a hack in the side of each tree.

WISCONSIN COORDINATE SYSTEM

SURVEY CONTROL ORDER

Horizontal	_____
Vertical	_____

Corner	East (X)	North (Y)	Elevation (Z)	Zone
Control Sta. Name				

~~City/Village of~~ Town of Lincoln

County of Monroe