

CERTIFICATE

CERTIFIED LAND CORNER

No. 115

21901312000



H. A. Sime and Associates
P. O. Box 705
Tomah, Wisconsin 54660
Phone: (608)-372-5392

I, Bryan H. Meyer, do hereby certify that on the 10th day of July 19 91, I found ~~evidence~~ (no evidence) of the West 1/4 corner of Section 32, T 19 N, R 1 W Fourth Principal Meridian, and I re-established said corner according to the Wisconsin Statutes as shown and described hereon.

History of corner establishment since Original Government Survey

O. R. Dahl was here sometime during his tenure as County Surveyor between 1867 and 1869.

Description of corner evidence found:

I set this corner on line and equi-distant between the Northwest and Southwest corners of Section 32.

Dated this 17th day of July 19 91.


Bryan H. Meyer
Deputy County Surveyor
Title

COUNTY SURVEYOR FORM NO. 1

Description of corner and witness monuments, references and accessories used to perpetuate the original or re-established location of this corner:


Crew: Kenworthy, Kostka
Date: July 10, 1991
Weather: Sunny, 85°±
Witnesses to corner location:

John Kenworthy
Brent Kostka
Bryan H. Meyer

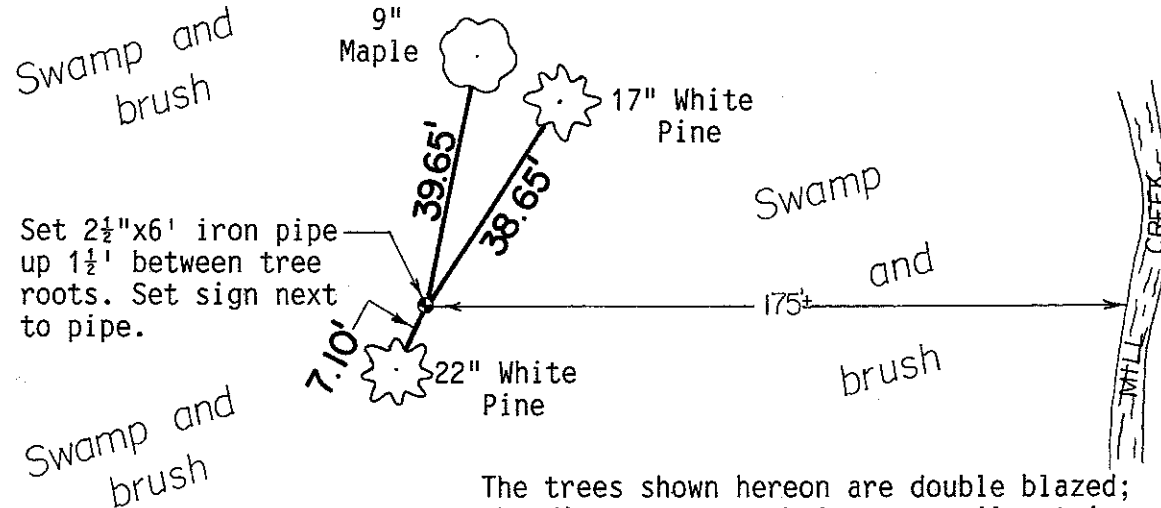

Set 2 1/2" x 6' iron pipe up 1 1/2' between tree roots. Set sign next to pipe.

The trees shown hereon are double blazed; the distance to each is to a nail set in a hack in the side of each tree.

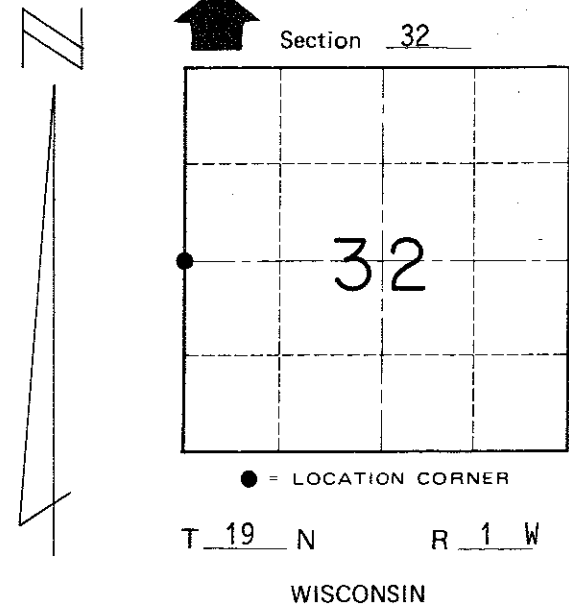

SURVEY CONTROL ORDER

Table with 2 rows: Horizontal, Vertical

WISCONSIN COORDINATE SYSTEM

Table with 5 columns: Corner, East (X), North (Y), Elevation (Z), Zone

~~City, Village or~~ Town of Lincoln

County of Monroe