

U.S. LAND CORNER MAINTENANCE

Corner ID : E1/4 Sec.23 , T19N-R1W
21901232000

<u>DATE</u>	<u>CREW</u>	<u>MONUMENT TYPE</u> -----
June 13, 2013	Zachariah P. Dechant Gary L. Dechant	Existing Harrison west side of road Set mag nails 1' north & 1' west

References:

Set 1/2" rebar down 6", 3'SE 24" white pine
Set 1/2" rebar down 6"


Bearing

N57E
S57W

Distance

82.63'
59.30'

NOTE: Harrison and rebars set on straight line.

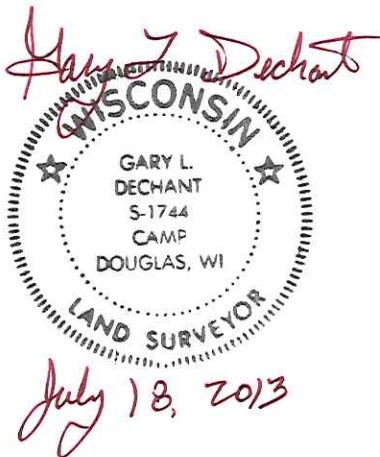

21901232000

I, William C. Jung, do hereby certify that on the 26th day of May 1978, I found ~~(evidence)~~ (no evidence) of the E 1/4 corner of Section 23, T 19 N, R 1 W, Fourth Principal Meridian, and I re-established said corner according to the Wisconsin Statutes as shown and described hereon.

History of original corner establishment:

Fred Holden set an iron pipe 24.75 feet east of the corner in January of 1902.

Description of corner evidence found:

Set the corner on line and equidistant between the Section corners.
Could not find the pipe.

*7-24-86 Remarked with white
Set sign + post 17' West of corner.*

Dated this 12th day of Dec. 1978.

William C. Jung, R.L.S. 1323

Crew Chief, County Surveyor's
Title Office

COUNTY SURVEYOR FORM NO. 1


Description of corner and witness monuments, references and accessories used to perpetuate the original or re-established location of this corner:

Set Harrison flush in road.

Witnesses to corner location:

W. Jung

G. Dechant

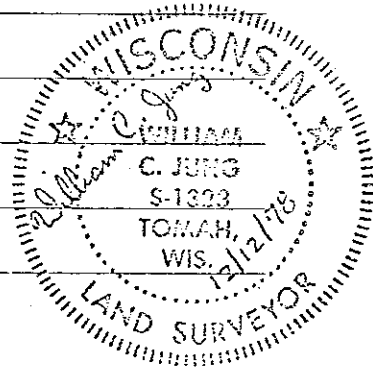

Note: Found the bottom 1/3 of the Harrison still in place. I replaced this portion with a new Harrison Monument.

Crew: Bryan H. Meyer, R.L.S.
Brian Forsythe

Date: May 18, 1980 (downed fence)



16" Double Pine




8" White Pine



(All trees double blazed with N&C's set)

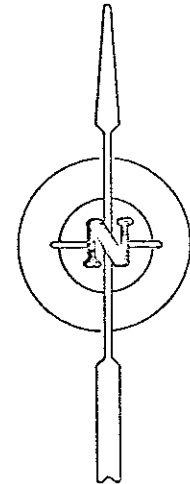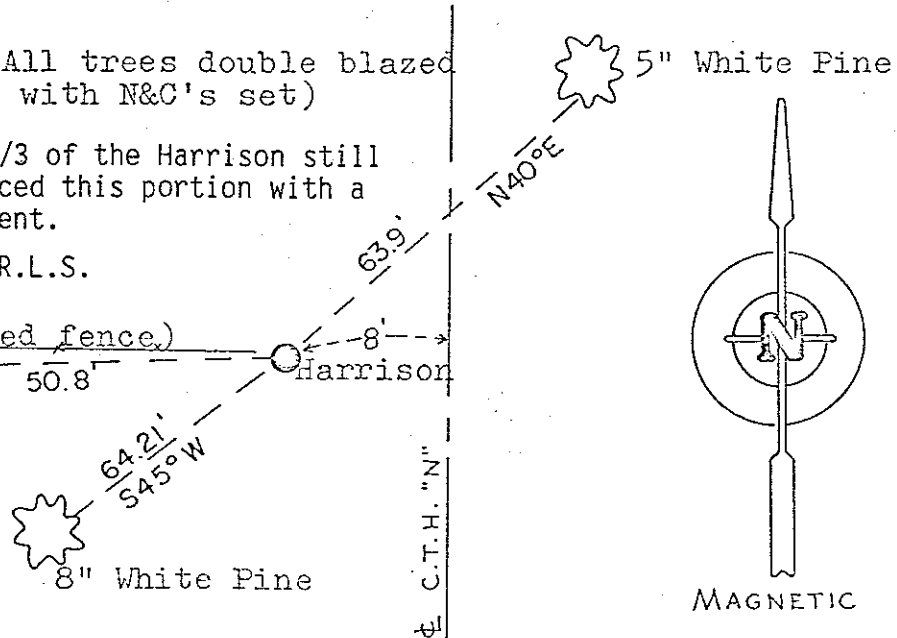

Section 23

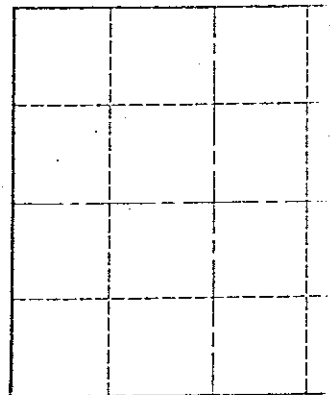

• = LOCATION CORNER

T 19 N R 1 W
WISCONSIN

SURVEY CONTROL ORDER

Horizontal _____

Vertical _____

Approved by: Harley A. Sime
County Surveyor

WISCONSIN COORDINATE SYSTEM

Corner	East (X)	North (Y)	Elevation (Z)	Zone
Control Sta. Name				

City, Village or Town Lincoln

County of Monroe