

CERTIFICATE

CERTIFIED LAND CORNER

No. 104

21901260020

I, Ronald D. Parish, do hereby certify that on the 12th day of December 1980, I found ~~(evidence)~~ (no evidence) of the S 1/4 corner of Section 26, T 19 N, R 1 E, Fourth Principal Meridian, and I re-established said corner according to the Wisconsin Statutes as shown and described hereon.

History of original corner establishment:
Holden does not show that a corner was set here.

Dated this 8th day of Jan. 1981.

Description of corner evidence found:

Set the corner on line equal distance from the SW corner and the SE corner.

Ronald D. Parish

Registered Land Surveyor #S-1460
Title



COUNTY SURVEYOR FORM NO. 1

Description of corner and witness monuments, references and accessories used to perpetuate the original or re-established location of this corner:

Witnesses to corner location:

R. Parish

T. Schmitz

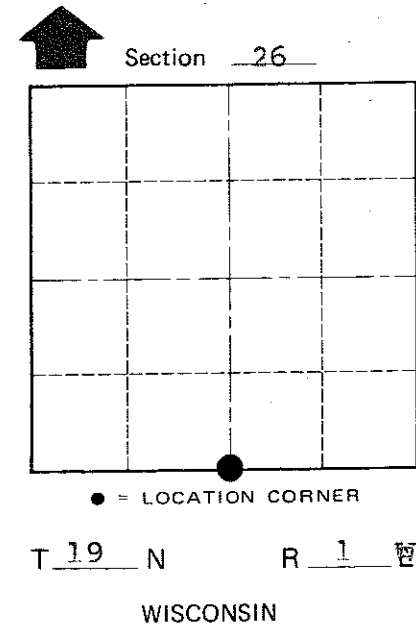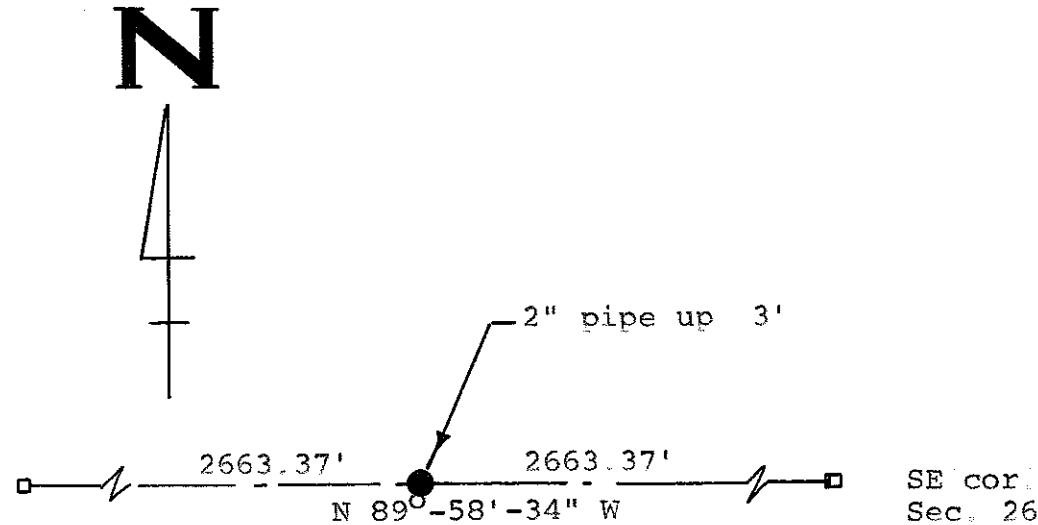

SURVEY CONTROL ORDER

Horizontal _____

Vertical _____

WISCONSIN COORDINATE SYSTEM

Corner	East (X)	North (Y)	Elevation (Z)	Zone
Control Sta. Name				

City, Village or Town Lincoln

County of Monroe