66

U.S. PUBLIC LAND CORNER MAINTENANCE

Corner ID: S1/4 Sec. 15, T19N-R1W

21901150020

DATE	CREW	MONUMENT TYPE		
March 3, 2016	Zachariah P.Dechant Gary L. Dechant	Existing Harrison, top broke off, down 10", 1' south of Broadway Ave, 52' west of driveway F.N. 25555 Broadway		
References:		<u>Bearing</u>	<u>Distance</u>	
1) Set3/4"x24" iron bar, down 6"		N39E	42.89°	
2) Set3/4"x24" iron bar, do	wn 6", 9' east of 8" White Pine	S23E	40.13'	
3) Set 3/4"x24" iron bar, dov	vn 6, top of dike of cranberry bed	S39W	62.13'	
4) Sett 3/4"x24" iron bar, do	wn 6"	N23 W	34.56'	

Harrison and Reference markers set on straight lines.

GARY L.
DECHANT
S-1744
CAMP
DOUGLAS, WI
ZO
SURVENIMENT

U. S. PUBLIC LAND SURVEY MONUMENT RECORD


INSTRUCTIONS:

This record shall show the location of the corner and shall include all of the following nine elements (a through i).

- (a) Identify the corner by reference to the U.S. public land survey system.
 - ()= Corner monument restored.

South 1/4 corner of Section 15, T19N, R1W, Fourth Principal Meridian, Town of Lincoln, Monroe County, Wisconsin.

See Reverse Side For Maintenance

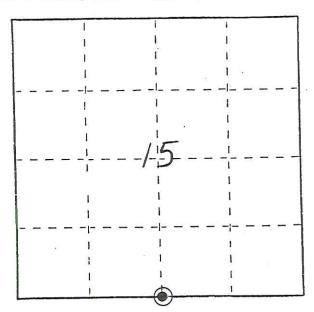


(b) Describe any record evidence, monument evidence, occupational evidence, testimonial evidence or any other material evidence you considered, and whether the monument was found or placed.

The Harrison monument at this corner and two witness monuments were found on March 30, 1993 by Michael L. Deems. (See previous Certified Land Corner record by Harley A. Sime dated March 2, 1976). Two additional witness monuments were set as shown below.

- (c) In the plan view drawing below, provide reference ties to at least 4 witness monuments, or, if the location is within a municipality, to at least 2 witness monuments. (Witness monuments shall be made of concrete, natural stone, iron or other equally durable material.)

 Describe witness monuments.
- (d) Show a plan view drawing depicting the relevant monuments and reference ties which is sufficient in detail to enable accurate relocation of the corner monument if the corner monument is disturbed. Indicate north.

FOUND NAIL & CAP
IN POWER POLE

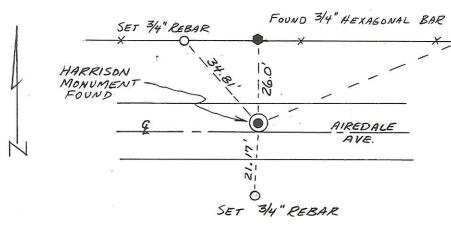

2190115002

I, Harley A. Sime ___, do hereby certify that on the __ _19_75, I found of November (evidence) (no evidence) of the South 1/4 corner of Section 15, T 19 N, R 1 W Fourth Principal Meridian, and I reestablished said corner according to the Wisconsin Statutes as shown and described hereon.

Dated this 2nd day of March 1976.

History of original corner establishment:

Henry Schroeder surveyed along the North line of Section 22 in June of 1893.

Description of corner evidence found:

Except for the road, there was no evidence at this corner. Set the corner on line between the section corners and at a distance from the S.E. corner that is double the distance from the S.E. corner to the occupied forty corner at the S1/16-SE1/4-Sec. 15.

County Surveyor

Title Approved: HARLEY A. SIME MONROE CO. SURVEYOR

A STATE OF THE STA	nces and accessories used to perpetuate the original or re-established location of ead, 1 ft.+ North of the centerline.	this corner:	Section	15
Witnesses to corner location: G. Sime - Crew Chief	Set a 3/4" hexagon bar in the fence	n&c in a power		
L. Feddersen				
C. Pietz	Centerline O Town Road	N		
			O = LOCATIO) CORNER
SURVEY CONTROL ORDER	Ø n&c in a telephone	See Reverse Side For Maintenance	T_19_N wiscon	R 1 W

SURVEY CONTROL ORDER φ n&c in a telephone pole Horizontal Vertical WISCONSIN COORDINATE SYSTEM East (X) North (Y) Elevation (Z) Zone Corner Control Sta. Name

City, Village or Town Lincoln County of __Monroe