

CERTIFICATE

CERTIFIED LAND CORNER

No. 69

21901170000

I, Harley A. Sime, do hereby certify that on the _____ day of October 1975, I found (evidence) (~~no evidence~~) of the Southwest corner of Section 16, T 19 N, R 1 W Fourth Principal Meridian, and I re-established said corner according to the Wisconsin Statutes as shown and described hereon.

History of original corner establishment:

Description of corner evidence found:

Dated this 2nd day of March 1976.

Found a 2" pipe. Removed said pipe and replaced it with a Harrison marker. This pipe had been used in previous survey work.

County Surveyor Approved: HARLEY A. SIME
Title _____
MONROE CO. SURVEYOR



Description of corner and witness monuments, references and accessories used to perpetuate the original or re-established location of this corner:

Set a Harrison marker.

Witnesses to corner location:

G. Sime-Crew Chief

D. Malliet

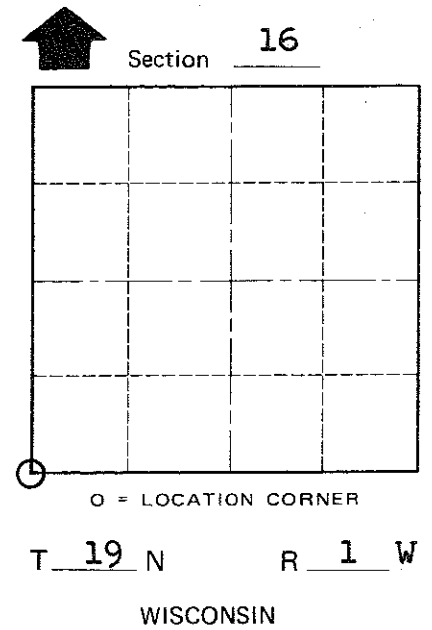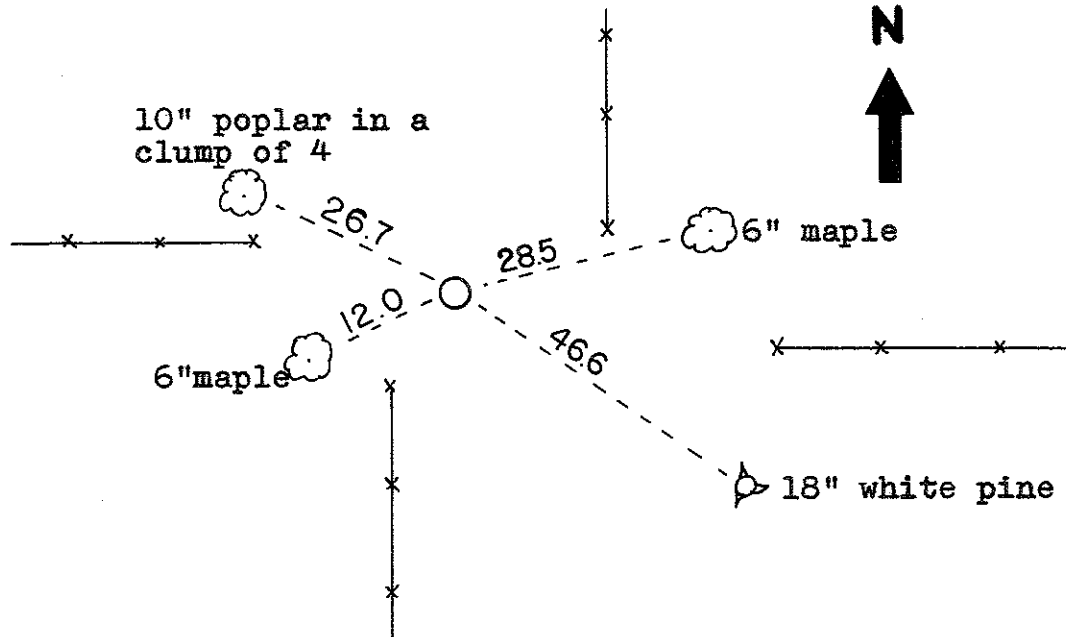

COUNTY SURVEYOR FORM NO. 1

SURVEY CONTROL ORDER

Horizontal	_____
Vertical	_____

WISCONSIN COORDINATE SYSTEM

Corner	East (X)	North (Y)	Elevation (Z)	Zone
Control Sta. Name				

City, Village or Town Lincoln
County of Monroe