

123

**U.S. PUBLIC LAND CORNER
MAINTENANCE**

Corner ID : SE, Sec. 35, T19N-R2W

21902350000

<u>DATE</u>	<u>CREW</u>	<u>MONUMENT TYPE</u> -----
March 9, 2017	Zachariah P.Dechant Gary L. Dechant	Existing Harrison intact, down 2" in new pavement 110' south of driveway 6962 Cherry Road, In center line Cherry Road, 8' north of west fence

References:

	<u>Bearing</u>	<u>Distance</u>
1) Set 3/4"x24" round iron bar, down 6", in lawn	N71E	35.37'
2) Set 3/4"x24" round iron bar, in field down 12"	S63E	46.15'
3) Set 3/4"x24" round iron bar, down 8, 13' west of new power pole	S71W	44.50'
4) Set 3/4"x 24" round iron bar, down 6", concrete block over bar	N63W	37.82'

Harrison and reference markers set on straight lines



I, Ronald D Parish, do hereby certify that on the 8th day of September 1981. I found (evidence) (no evidence) of the SE Cor corner of Section 35, T 19 N, R 2 W Fourth Principal Meridian, and I re-established said corner according to the Wisconsin Statutes as shown and described hereon.

Dated this 14th day of Sept 1981.
Ronald D Parish, R.L.S. 1460

Title

History of corner establishment since Original Government Survey

No subsequent history of monument perpetuation since the original U S Government Survey

Description of corner evidence found:

Set the corner on line extended from the SW corner of Section 35 thru The S 1/2 corner of Section 35 and the intersection of the centerline of 21st Avenue

Approved: **HARLEY A. SIME**
MONROE CO. SURVEYOR

See Reverse Side For Maintenance

COUNTY SURVEYOR FORM NO. 1

Description of corner and witness monuments, references and accessories used to perpetuate the original or re-established location of this corner:


Orange Paint on West End of 18" CMP

Witnesses to corner location:


Ronald D Parish
Todd J Schmitz

Set Nail & Washer in Power Pole w/Transformer

29.45'

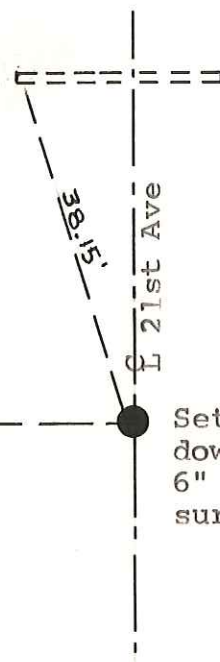

Set Harrison down approx 6" in Bit surface

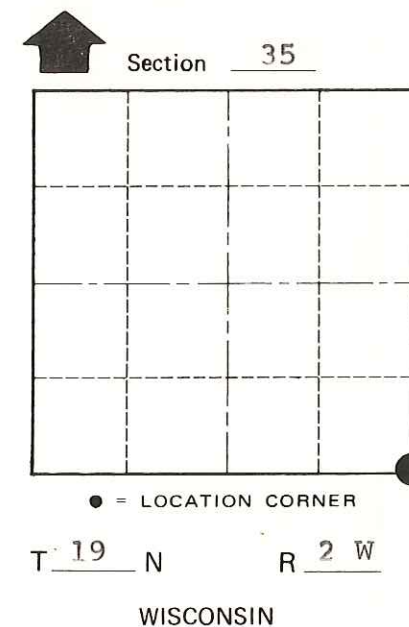

SURVEY CONTROL ORDER

Horizontal	_____
Vertical	_____

WISCONSIN COORDINATE SYSTEM

Corner	East (X)	North (Y)	Elevation (Z)	Zone
Control Sta. Name				

City, Village or Town Grant
County of Monroe