

CERTIFICATE

CERTIFIED LAND CORNER

No. 133

21902360000

I, Harley A. Sime, do hereby certify that on the 15th day of October 1974, I found (evidence) (~~no evidence~~) of the Southwest corner of Section 31, T19 N, R1 W, Fourth Principal Meridian, and I re-established said corner according to the Wisconsin Statutes as shown and described hereon.

Dated this 3rd day of March 1976.

History of original corner establishment:

Fred Holden (County Surveyor) found the original government bearing trees at this corner in June of 1908.

Description of corner evidence found:

An existing 4-way fence was located at this corner and accepted as the best available evidence. The corner as set fits existing conditions and records.

County Surveyor Approved: HARLEY A. SIME
MONROE CO. SURVEYOR



Description of corner and witness monuments, references and accessories used to perpetuate the original or re-established location of this corner:

Set a Harrison marker in the fence corner.

Witnesses to corner location:

K. Pritzlaff-Crew Chief

D. Malliet

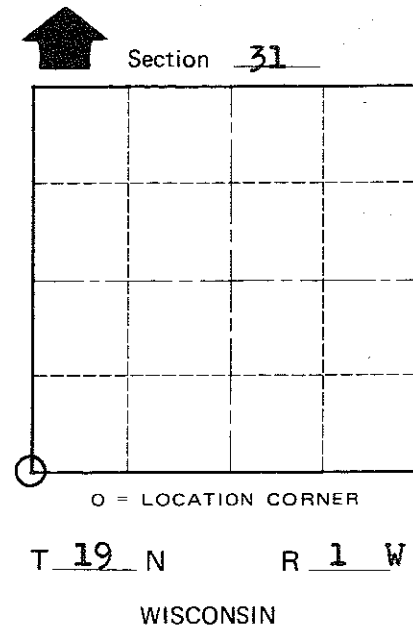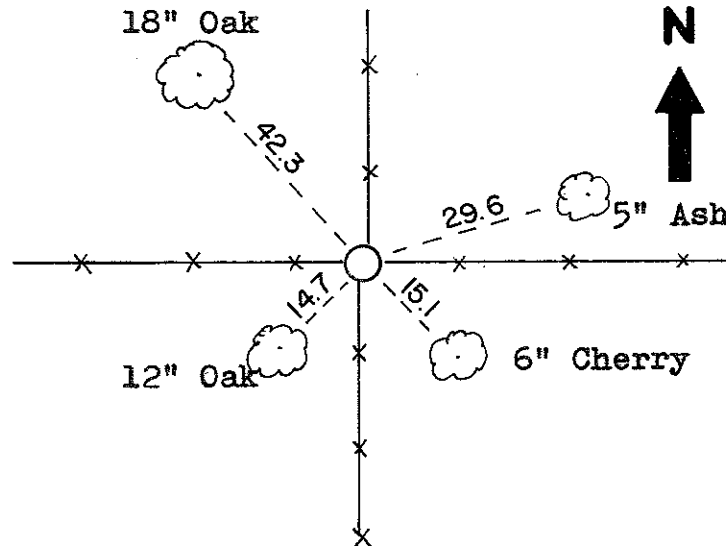

Note: All trees have nails and caps in them.

COUNTY SURVEYOR FORM NO. 1

SURVEY CONTROL ORDER

Horizontal	_____
Vertical	_____

WISCONSIN COORDINATE SYSTEM

Corner	East (X)	North (Y)	Elevation (Z)	Zone
Control Sta. Name				

City, Village or Town Lincoln
County of Monroe