

**U.S. PUBLIC LAND CORNER
MAINTENANCE**

38

**Corner ID: W1/4 Sec. 11, T19N-R2W
21902102000**

<u>DATE</u>	<u>CREW</u>	<u>MONUMENT INFO</u>
March 27, 2020	Zachariah P. Dechant Gary L. Dechant	Existing Stone (+) in remnants of north-south fence Set sign 1' north and older sign 1' south

	<u>Compass Bearing</u>	<u>Distance</u>
1) Set 3/4"x24" round iron bar, down 6", 4' SW of 18" White Oak (Holden's BT)	N53E	8.57'
2) Set 3/4"x24" round iron bar, down 6", 3' NW of 6" White Oak	S54E	19.55'
3) Set 3/4"x24" round iron bar, 3' NE of 5" Maple	S13W	22.55'
4) Set 3/4"x24" round iron bar, 4' SE of 14" White Pine	N45W	10.63'

Gary L. Dechant
WISCONSIN
GARY L.
DECHANT
S-1744
DOUGLAS, WI
LAND SURVEYOR
March 31, 2020

I, Harley A. Sime, do hereby certify that on the 8 day of September 1977, I found (evidence) (~~no evidence~~) of the W 1/4 corner of Section 11, T 19 N, R 2W Fourth Principal Meridian, and I re-established said corner according to the Wisconsin Statutes as shown and described hereon.

Dated this 9 day of Sept. 1977.

History of original corner establishment:

Holden re-established this corner in 1902, and set a stone here in 1908.

Description of corner evidence found:

Found Holden's stone, and also both trees still standing.



Approved: HARLEY A. SIME
MONROE CO. SURVEYOR


See Reverse Side For Maintenance

Description of corner and witness monuments, references and accessories used to perpetuate the original or re-established location of this corner:



Found a stone in the N-S fence, up 2".

Witnesses to corner location:
W. C. Jung - Crew Chief
G. L. Dechant

Found stone with "X" up 2', set 3/4"x24" iron bar on North side and set White Oak post on South side.

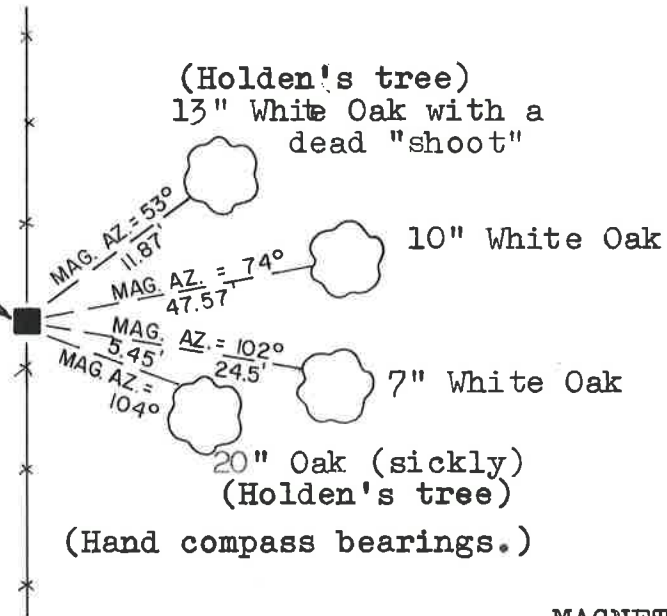

Note: All trees doubled blazed with N&C's set.

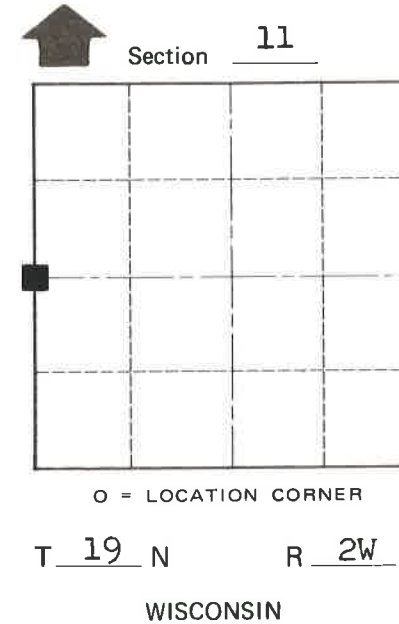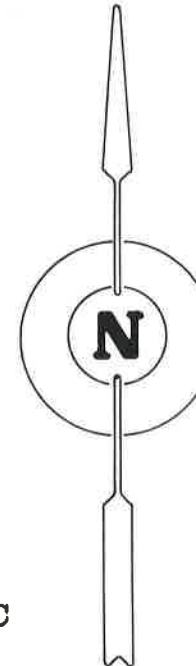

COUNTY SURVEYOR FORM NO. 1

SURVEY CONTROL ORDER

Horizontal	_____
Vertical	_____

WISCONSIN COORDINATE SYSTEM

Corner	East (X)	North (Y)	Elevation (Z)	Zone
Control Sta. Name				

MAGNETIC NORTH

City, Village or Town Grant
County of Monroe