

21902122000

I, Mark R. Heidecke, do hereby certify that on the 13th day of May 1980, I found ~~XXXXXX~~ (no evidence) of the East Quarter corner of Section 12, T 19 N, R 2 W Fourth Principal Meridian, and I re-established said corner according to the Wisconsin Statutes as shown and described hereon.

Dated this 13th day of May 1980.

Mark R. Heidecke
Registered Land Surveyor
Title

History of corner establishment since Original Government Survey

No subsequent history of monument perpetuation since the Original U. S. Government Survey.



Description of corner evidence found:

After searching the area for evidence and finding none, a Harrison monument was set at the corner. The corner was established by extending East the line between Stone monuments found at the Center of Section 12 and the CE 1/16 Corner of Section 12 and doubling the distance. This location agrees well with local conditions.

Description of corner and witness monuments, references and accessories used to perpetuate the original or re-established location of this corner:

Witnesses to corner location:

Mark R. Heidecke
Lawrence A. Feddersen

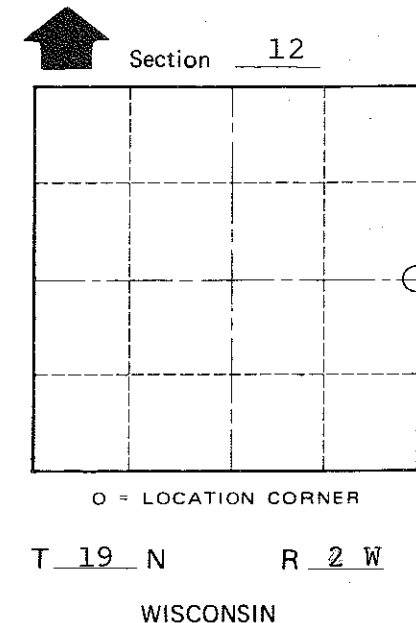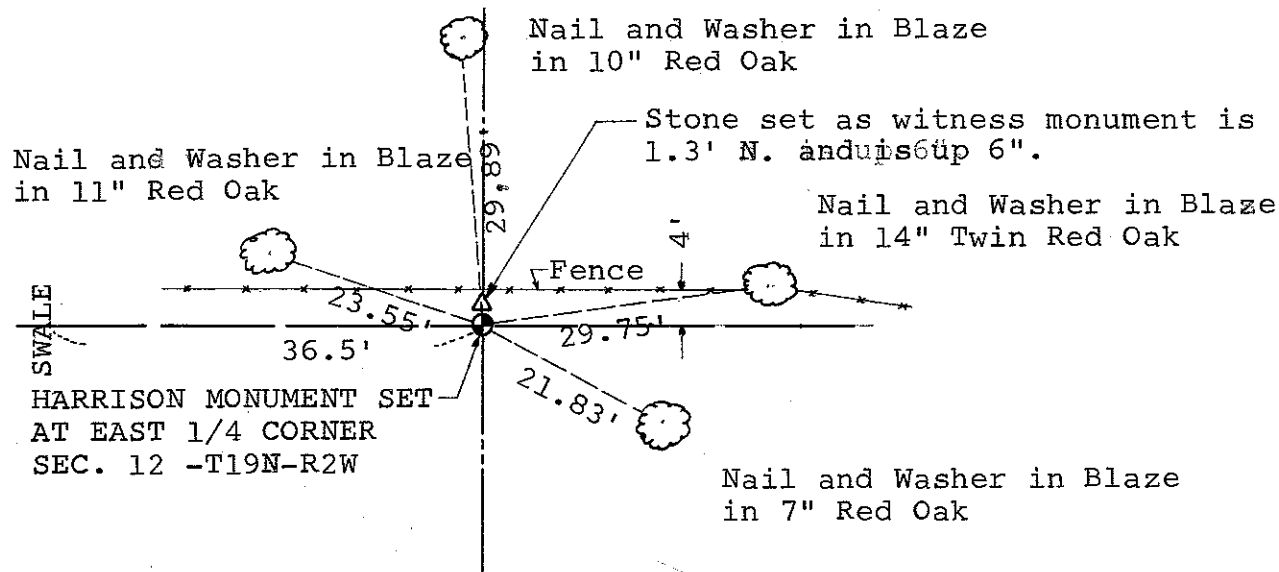

COUNTY SURVEYOR FORM NO. 1

SURVEY CONTROL ORDER

Horizontal	_____
Vertical	_____

WISCONSIN COORDINATE SYSTEM

Corner	East (X)	North (Y)	Elevation (Z)	Zone
Control Sta. Name				

~~XXXXXX~~ City, Village or Town of Grant
County of Monroe
Wisconsin