

CERTIFICATE

CERTIFIED LAND CORNER

No. 125

21904340000

I, Harley A. Sime do hereby certify that on the nineteenth day of June 1980 I found (evidence) ~~(evidence)~~ of the Southwest corner of Section 35, T19 N, R 4 W Fourth Principal Meridian, and I re-established said corner according to the Wisconsin Statutes as shown and described hereon.

History of corner establishment since Original Government Survey

No recorded history since the original government survey.

Description of corner evidence found:

Set on line with fence to the North and proportionate to the original government notes.

Dated this eighth day of Jan. 1981.

Harley A. Sime - R.L.S. 355

County Surveyor-Monroe County Wisconsin.

COUNTY SURVEYOR FORM NO. 1

Description of corner and witness monuments, references and accessories used to perpetuate the original or re-established location of this corner:


Witnesses to corner location:

Gary Dechant


M. Scott Sowers

Todd Tormoen

All Trees Double Blazed With Nail & Caps Set

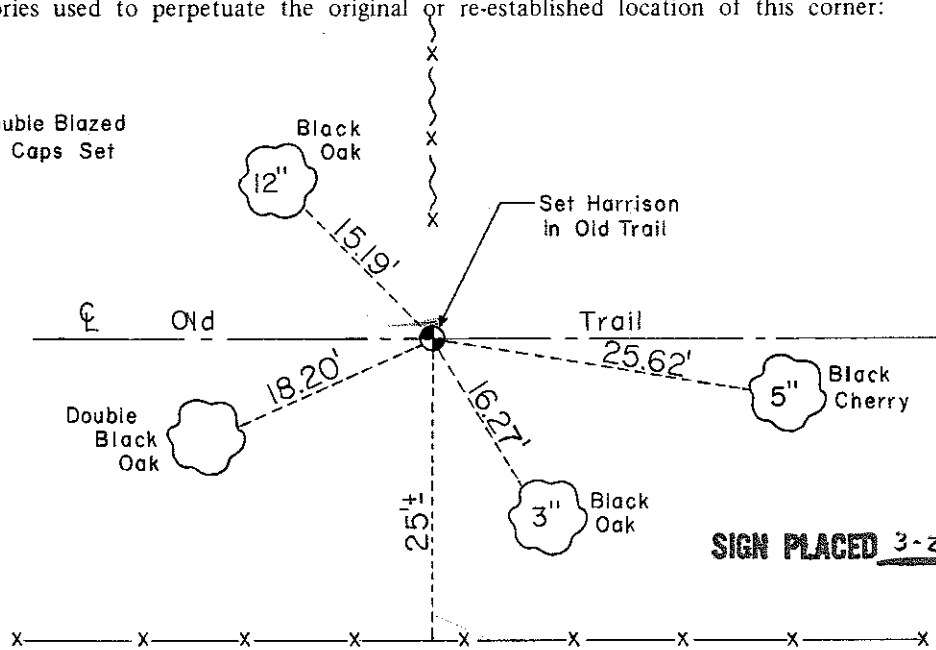

SIGN PLACED 3-28-90 *[Signature]*

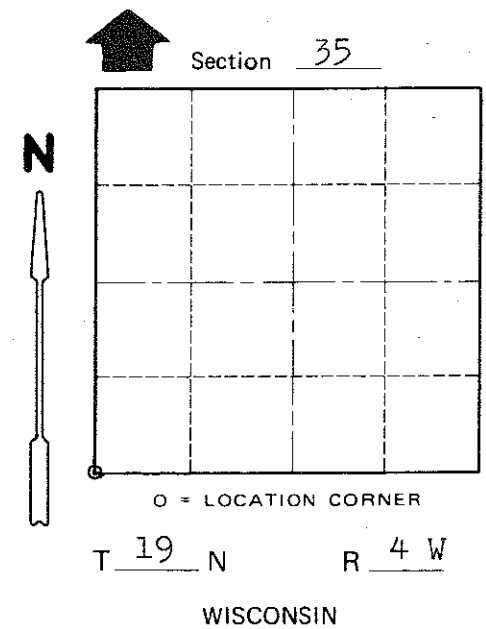

Approved: **HARLEY A. SIME**
MONROE CO. SURVEYOR

SURVEY CONTROL ORDER

Horizontal	_____
Vertical	_____

WISCONSIN COORDINATE SYSTEM

Corner	East (X)	North (Y)	Elevation (Z)	Zone
Control Sta. Name				

~~City, Village or~~ Town of Little Falls

County of Monroe
Wisconsin