

CERTIFICATE

CERTIFIED LAND CORNER

No. 97 J

21904271000

I, Garold A. Sime, do hereby certify that on the 16th day of June 1976, I found (evidence) (~~no evidence~~) of the E 1/16 SE 1/4 corner of Section 27, T 19 N, R 4 W Fourth Principal Meridian, and I re-established said corner according to the Wisconsin Statutes as shown and described hereon.

History of original corner establishment:

Dated this 7th day of Feb. 1978.

Description of corner evidence found:

Garold A. Sime, R.L.S. 1261

Found a pipe used in previous survey.

Crew Chief, County Surveyor's
Title Office



**Approved: HARLEY A. SIME
MONROE CO. SURVEYOR**

COUNTY SURVEYOR FORM NO. 1

Description of corner and witness monuments, references and accessories used to perpetuate the original or re-established location of this corner:

Witnesses to corner location:

G. Sime
D. Dade
B. Meyer

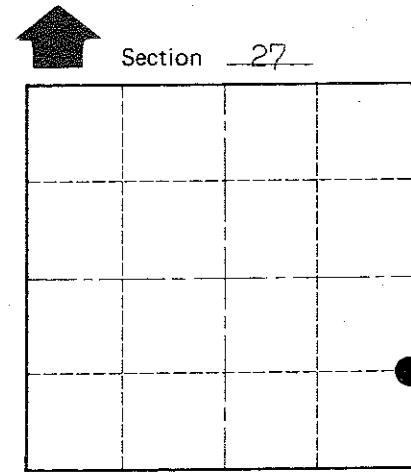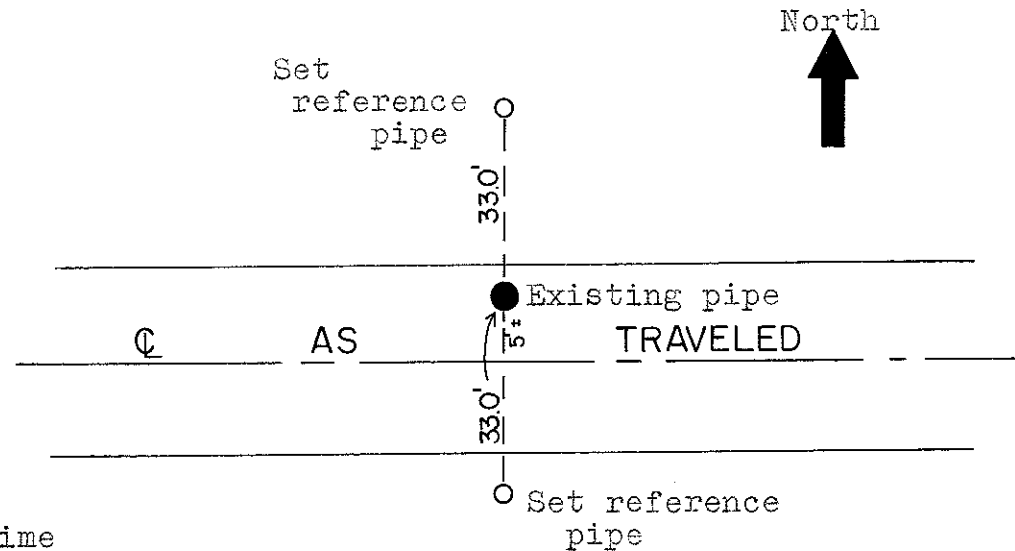

O = LOCATION CORNER

T 19 N R 4 W

WISCONSIN

Approved by: Harley A. Sime
County Surveyor

SURVEY CONTROL ORDER

Horizontal	_____
Vertical	_____

WISCONSIN COORDINATE SYSTEM

Corner	East (X)	North (Y)	Elevation (Z)	Zone
Control Sta. Name				

City, Village or Town Little Falls

County of Monroe