

21904112000

I, Harley A. Sime, do hereby certify that on the 26th day of October 1981 I found (evidence) ~~(evidence)~~ of the W¹/₄ corner of Section 12, T19 N, R 4 W Fourth Principal Meridian, and I re-established said corner according to the Wisconsin Statutes as shown and described hereon.

Dated this 29th day of Oct. 1981
Harley A. Sime, R.L.S. 355

County Surveyor

Approved: HARLEY A. SIME
MONROE CO. SURVEYOR

Description of corner and witness monuments, references and accessories used to perpetuate the original or re-established location of this corner:

Witnesses to corner location:


G. Dechant
B. Meyer
C. Pietz

History of corner establishment since Original Government Survey
Keach set a stone here at an unknown date.
Holden set a stone here at an unknown date.
Blencoe in November of 1929 found both stones. Blencoe used Keach's stone and replaced it with a 30"x30"x11" stone(+).

Description of corner evidence found:

Found Blencoe's stone(+) of given dimensions in good condition, ties were taken.


COUNTY SURVEYOR FORM NO. 1

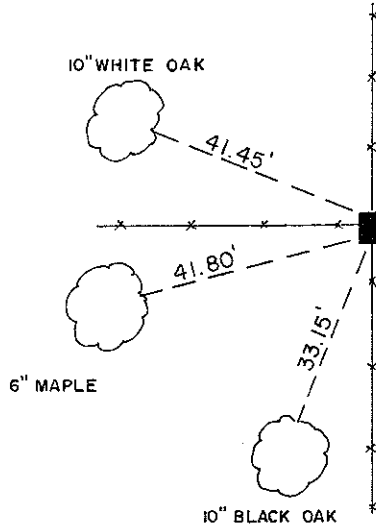

EXISTING STONE (+), SET 3/4" X 24" ROUND IRON BARS ON N & S SIDES OF STONE

SIGN PLACED 10-14-92

(Trees double blazed with nails set)

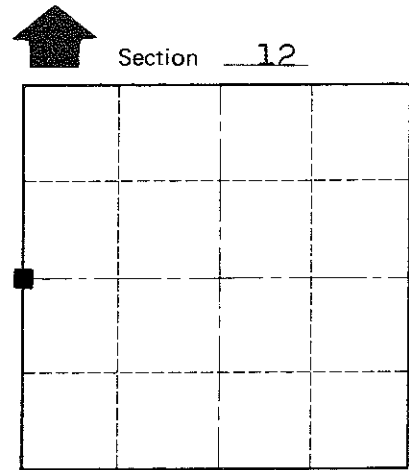

■ = LOCATION CORNER

T 19 N R 4 W
WISCONSIN

Approved: HARLEY A. SIME
MONROE CO. SURVEYOR

SURVEY CONTROL ORDER

Horizontal _____
Vertical _____

WISCONSIN COORDINATE SYSTEM

Corner	East (X)	North (Y)	Elevation (Z)	Zone
Control Sta. Name				

~~City, Village~~ Town Little Falls
County of Monroe