

21904072000

I, William C. Jung, do hereby certify that on the 4th day of June 1979 I found (evidence) (no evidence) of the East 1/4 corner of Section 7, T 19 N, R 4 W Fourth Principal Meridian, and I re-established said corner according to the Wisconsin Statutes as shown and described hereon.

Dated this 2nd day of Feb. 1981

William C. Jung

William C. Jung, R.L.S. 1323

History of corner establishment since Original Government Survey

Fred Holden was at this corner in August and September of 1904. Fred Zietlow set an iron bar at this corner in November of 1969.

Description of corner evidence found:

Found Zietlow's iron bar, removed it, and replaced it with a Harrison marker. I accepted this fence corner as the best available evidence of the original government corner.

Description of corner and witness monuments, references and accessories used to perpetuate the original or re-established location of this corner:

Witnesses to corner location:

W. Jung

B. Meyer

K.T. Webb



OPEN FIELD


6" Cherry

Removed 1 1/4" iron bar set Harrison.

21" Sickly Black Oak Single Blazed W/N&C

16" White Oak

WOODED AREA

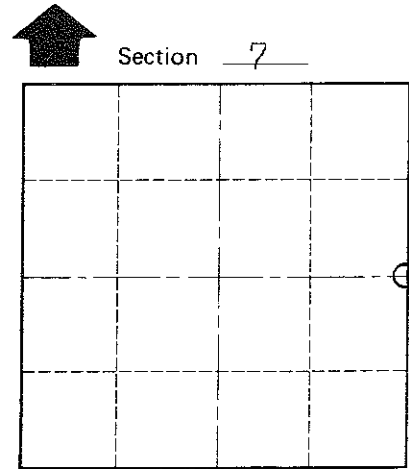

O = LOCATION CORNER

T 19 N R 4 W

WISCONSIN

Approved: HARLEY A. SIME MONROE CO. SURVEYOR

NOTE: All trees double blazed with N&C's set.

WISCONSIN COORDINATE SYSTEM

SURVEY CONTROL ORDER

Table with 2 rows: Horizontal, Vertical

Table with 5 columns: Corner, East (X), North (Y), Elevation (Z), Zone

City, Village or Town Little Falls

County of Monroe

Wisconsin

COUNTY SURVEYOR FORM NO. 1