

# 36

**U.S. PUBLIC LAND CORNER  
MAINTENANCE**

**Corner ID : E1/4 Sec. 8, T19N-R4W**

**21904082000**

<u>DATE</u>	<u>CREW</u>	<u>MONUMENT TYPE</u> -----
December 17, 2015	Zachariah P. Dechant Gary L. Dechant	Existing Harrison intact, at fence corner Set sign 1' north

References:

	<u>Bearing</u>	<u>Distance</u>
1) Set 3/4"x24" iron bar, down 12" in field,	N45E	21.90'
2) Set 3/4"x24" iron bar, down 12" in field	S40E	24.62'
3) Set 3/4"x24" iron bar, down, 12" in field	S42W	17.36'
4) Set 3/4"x24" iron bar, down 6", 4' north of 12" Ash	N67W	11.70'



I, Harley A. Sime, do hereby certify that on the 12th day of June 1981, I found (evidence) (~~no evidence~~) of the W<sup>1</sup>/<sub>4</sub> corner of Section 9, T 19 N, R 4 W Fourth Principal Meridian, and I re-established said corner according to the Wisconsin Statutes as shown and described hereon.

Dated this 27th day of August 1981.

Harley A. Sime, R.L.S. 355

County Surveyor

Approved: **HARLEY A. SIME**

**MONROE CO. SURVEYOR**

Description of corner and witness monuments, references and accessories used to perpetuate the original or re-established location of this corner:

History of corner establishment since Original Government Survey

Schroeder was here in May of 1886.  
Schroeder was here again in May of 1893.  
LaRue was here in October of 1897.

Description of corner evidence found:

Accepted a 3-way fence corner as best available evidence.

**See Reverse Side For Maintenance**

COUNTY SURVEYOR FORM NO. 1

Witnesses to corner location:



B. Meyer

C. Pietz



*F I E L D*

NOTE: No other good ties in immediate area.

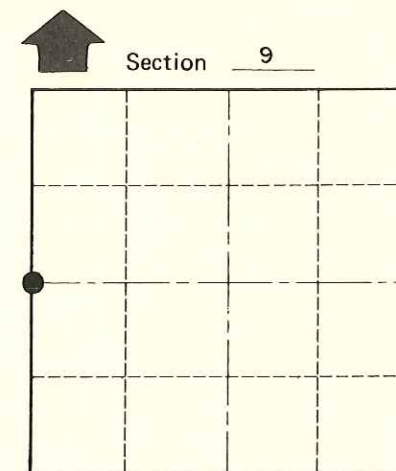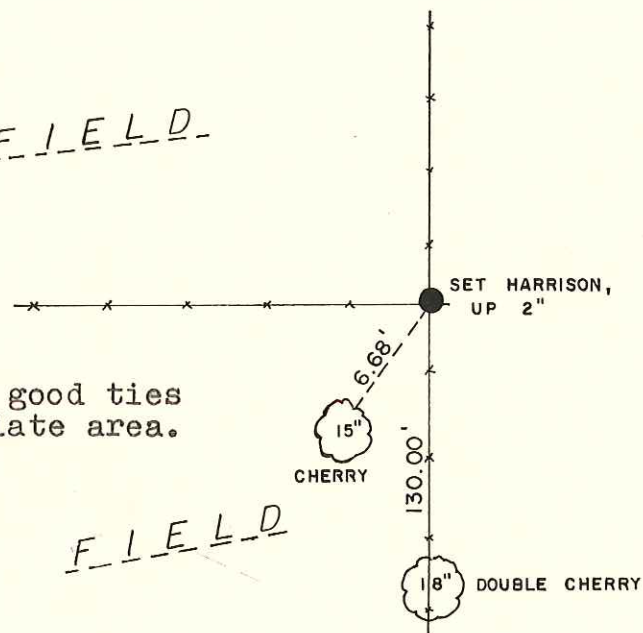

● = LOCATION CORNER

T 19 N R 4 W  
WISCONSIN

SURVEY CONTROL ORDER

Horizontal	_____
Vertical	_____

WISCONSIN COORDINATE SYSTEM

Corner	East (X)	North (Y)	Elevation (Z)	Zone
Control Sta. Name				

(Trees single blazed with nail set in lower blaze)\*

~~City, Village or~~ Town Little Falls

County of Monroe