

#35B

Corner ID: C1/4 Sec. 8, T19N-R4W


21904082020

# U.S. Public Land Survey Monument Record

Type of Monument: ~~Set (wooded) Mason Monument~~  
SET COTTON GIN SPIKE

Sec. 8, T19N-R4W

Field work: January 4, 2015

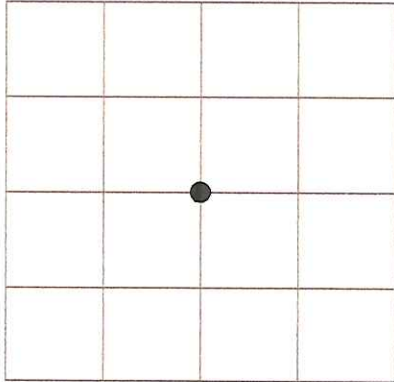

### County Coordinates:

### CERTIFICATE:

I, Gary L. Dechant, S-1744, do hereby certify that the corner location was determined under my direction and control as per Chapter AE-7 of the Wisconsin Administrative Code to the best of my knowledge and belief.

Witnesses: Zachariah P. Dechant  
Gary L. Dechant

Gary L. Dechant      March 31, 2016

### Basis For Monument Location:

(Show info such as history, evidence, testimony, found or method of relocation)

Hamilton LaRue was here in 1897 and may have set a stone. His numbers are hard to read.

Set cotton gin spike at location that corresponds with monuments set by Jonathan Schmitz in Vol 21 CSM, P. 139 in 2007, Kevin Boyer in Vol 19 CSM P 23 in 2005, and Dennis Melichar in Vol 26 CSM P 80 in 2014. See my CSM dated Dec. 31, 2015.

Did not dig up new pavement to look for a possible stone.  
Our computed corner fits occupation basically to the "letter".

COTTON GIN SPIKE & REFERENCE  
MARKERS ARE SET ON STRAIGHT LINES.

○ = SET 3/4" IRON BAR  
DOWN 12" IN FIELD

