

21904092000

I, Harley A. Sime, do hereby certify that on the 12th day of June 1981, I found (no evidence) of the E¹/₄ corner of Section 9, T19 N, R4 W Fourth Principal Meridian, and I re-established said corner according to the Wisconsin Statutes as shown and described hereon.

Dated this 28th day of August 1981.

Harley A. Sime, R.L.S. 355

County Surveyor

Title

Approved: **HARLEY A. SIME**

MONROE CO. SURVEYOR

Description of corner and witness monuments, references and accessories used to perpetuate the original or re-established location of this corner:

Witnesses to corner location:

B. Meyer

C. Pietz

History of corner establishment since Original Government Survey



Schroeder was here in May of 1886.

Blencoe was here in September of 1949 and found a 2x5 stone. (apparently Keach's)

Description of corner evidence found:

Set on line between NE and SE corners of Section 9 and on line with an East-West fence. Dug for the 2x5 stone but could not find it.

COUNTY SURVEYOR FORM NO. 1

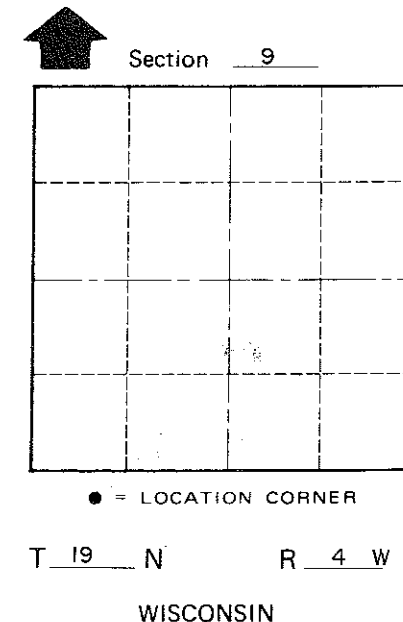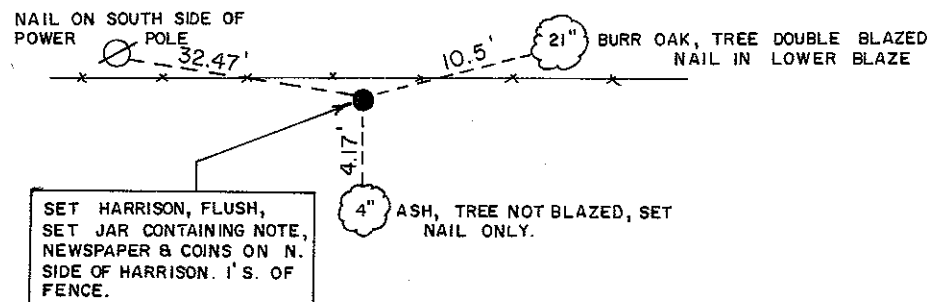

SURVEY CONTROL ORDER

Horizontal	_____
Vertical	_____

WISCONSIN COORDINATE SYSTEM

Corner	East (X)	North (Y)	Elevation (Z)	Zone
Control Sta. Name				

~~City Village or~~ Town Little Falls
County of Monroe