

CERTIFICATE

CERTIFIED LAND CORNER

No. 27

21904040000

I, Harley A. Sime,, do hereby certify that on the 8th day of June 1981, I found (evidence) (~~removed~~) of the NE corner of Section 9, T 19 N, R 4W ~~W~~, Fourth Principal Meridian, and I re-established said corner according to the Wisconsin Statutes as shown and described hereon.

History of original corner establishment:
David Blencoe was here in September of 1949 and set a stone. Keach was here sometime prior to Blencoe.

Dated this 27th day of August 1981.

Description of corner evidence found:
Found Blencoe's stone in a down N-S fence and replaced it with a Harrison Monument.

Harley A. Sime, R.L.S. 355

County Surveyor

Approved: **HARLEY A. SIME**
MONROE CO. SURVEYOR



Description of corner and witness monuments, references and accessories used to perpetuate the original or re-established location of this corner:

COUNTY SURVEYOR FORM NO. 1

Witnesses to corner location:

B. Meyer

G. Dechant

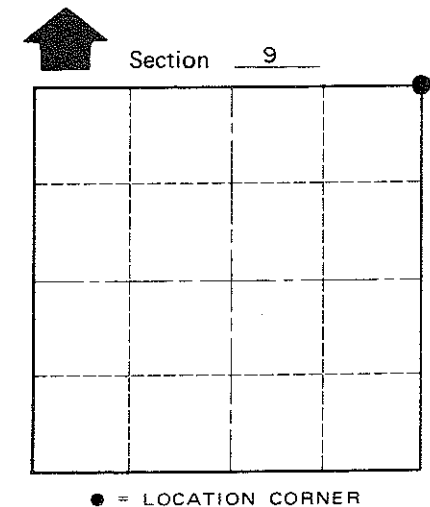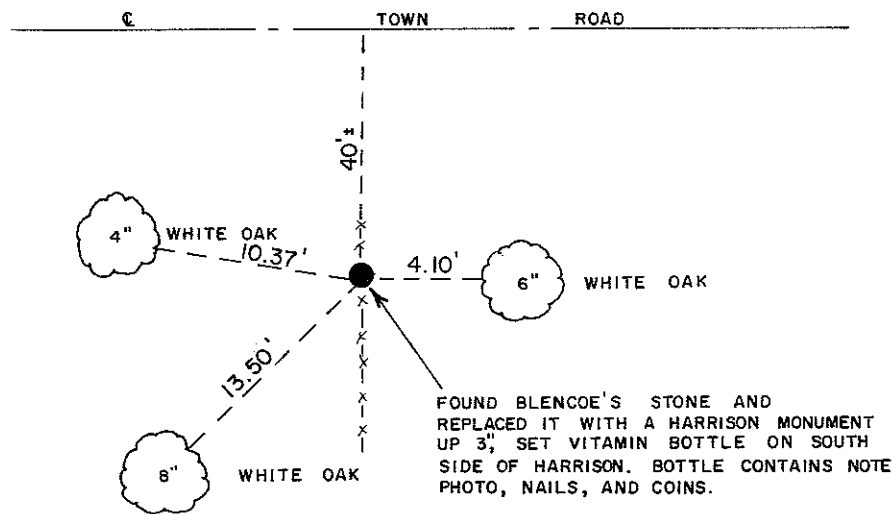

T 19 N R 4 W ~~W~~
WISCONSIN

FOUND BLENCOE'S STONE AND REPLACED IT WITH A HARRISON MONUMENT UP 3'; SET VITAMIN BOTTLE ON SOUTH SIDE OF HARRISON. BOTTLE CONTAINS NOTE, PHOTO, NAILS, AND COINS.

(Trees are double blazed with nail set in lower blaze)

SURVEY CONTROL ORDER

Horizontal	_____
Vertical	_____

WISCONSIN COORDINATE SYSTEM

Corner	East (X)	North (Y)	Elevation (Z)	Zone
Control Sta. Name				

~~City, Village or~~ Town Little Falls
County of Monroe