

21904052000

I, Harley A. Sime, do hereby certify that on the 9th day of November 1972 I found (evidence) (~~in evidence~~) of the E 1/4 corner of Section 5, T 19 N, R 4 W, Fourth Principal Meridian, and I re-established said corner according to the Wisconsin Statutes as shown and described hereon.

History of original corner establishment:

Description of corner evidence found:

Dated this 7 day of March 1977.

Accepted existing fence corner as best available evidence .

Approved: **HARLEY A. SIME**

County Surveyor **MONROE CO. SURVEYOR**



COUNTY SURVEYOR FORM NO. 1

Description of corner and witness monuments, references and accessories used to perpetuate the original or re-established location of this corner:

Set Harrison marker at fence corner.

Witnesses to corner location:

F. Zietlow
D. Marten
L. Feddersen

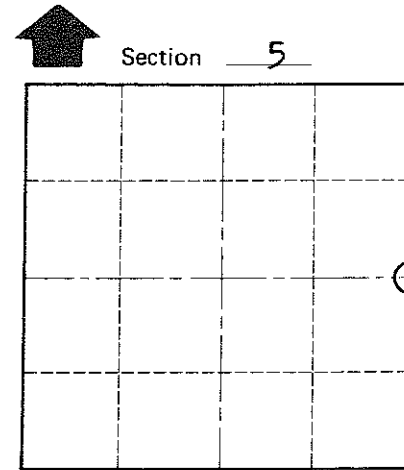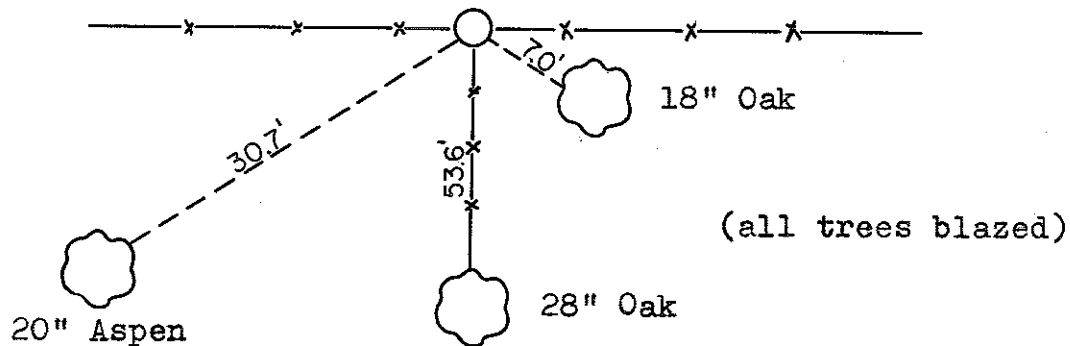

O = LOCATION CORNER
T 19 N R 4 W
WISCONSIN

SURVEY CONTROL ORDER

Horizontal	_____
Vertical	_____

WISCONSIN COORDINATE SYSTEM

Corner	East (X)	North (Y)	Elevation (Z)	Zone
Control Sta. Name				

City, Village or Town Little Falls
County of Monroe