



NOTES

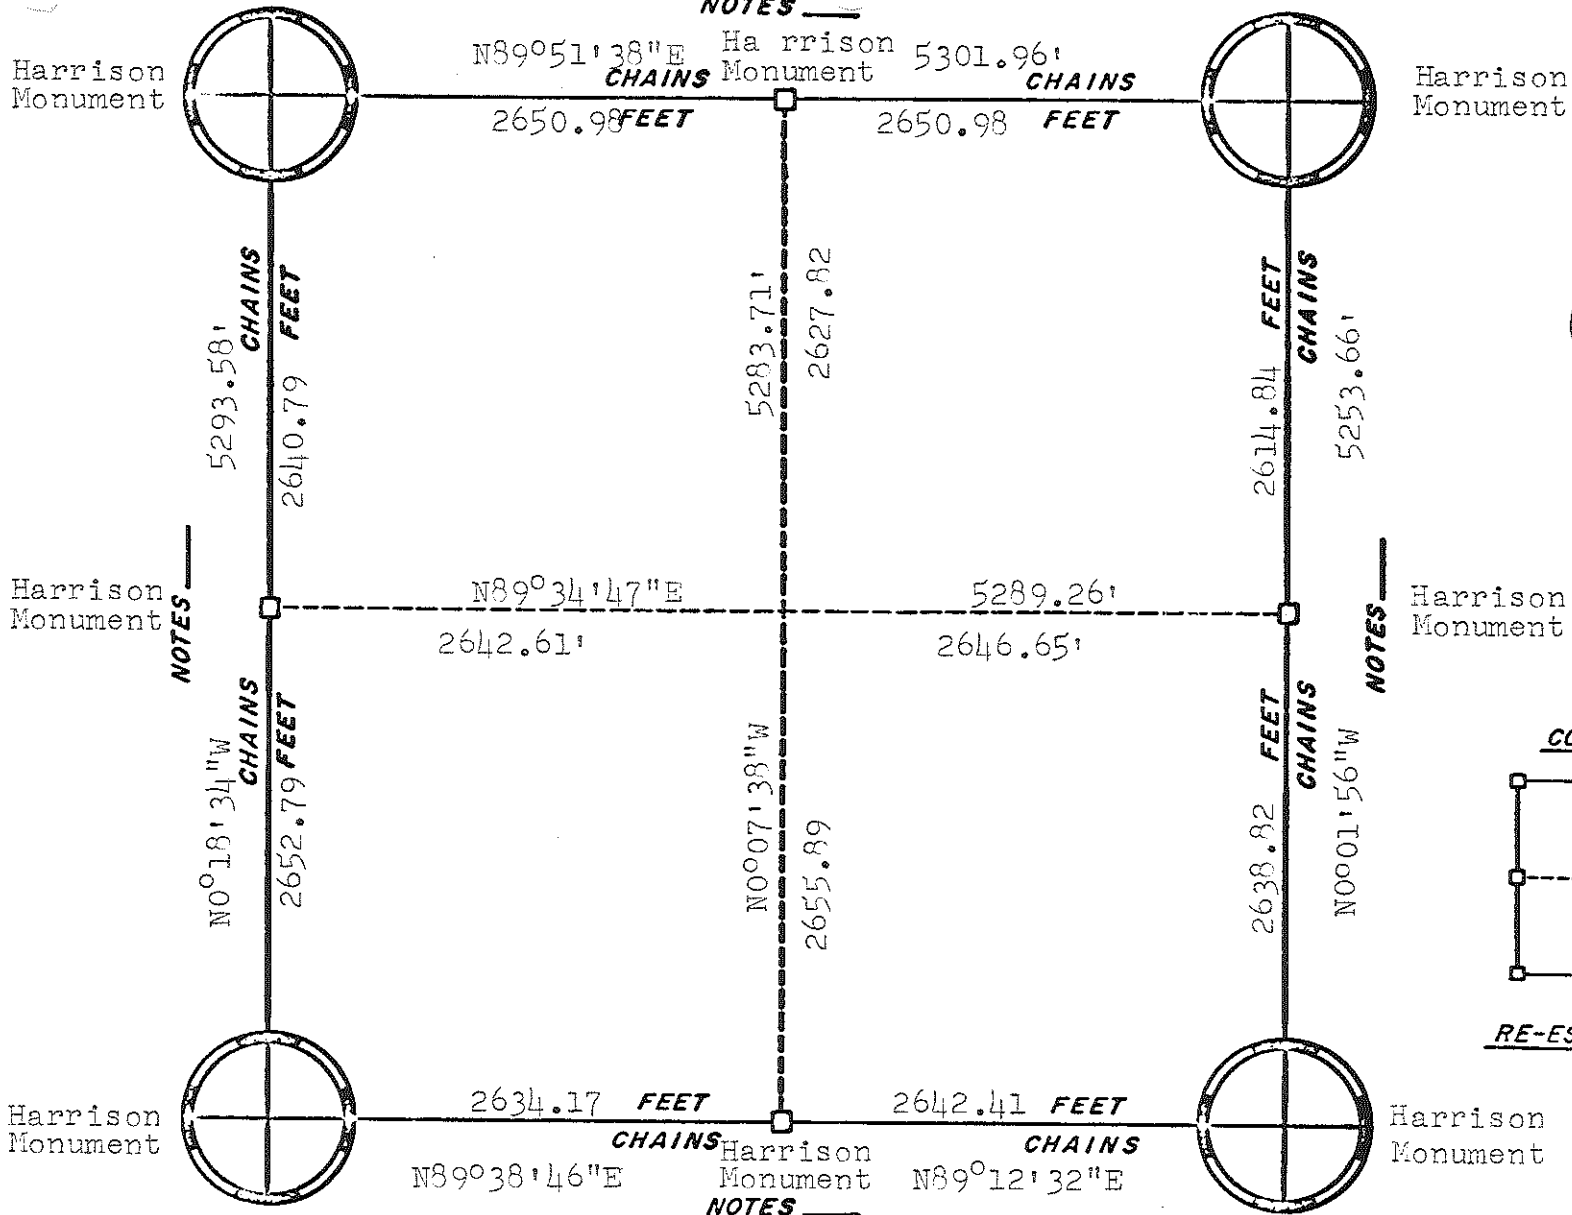

CORNERS

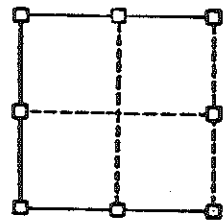


RE-ESTABLISHED

ORIGINAL SURVEY DATA

BY *R. Z. D*

DATE 3-5-79


SURVEYED BY D. J. Malliet	CONTRACT DATE March 1976	COUNTY MONROE [REDACTED]	TOWN-VILLAGE-CITY Little Falls	SECTION 13	TOWNSHIP 19N	RANGE 5W
------------------------------	-----------------------------	-----------------------------	-----------------------------------	---------------	-----------------	-------------

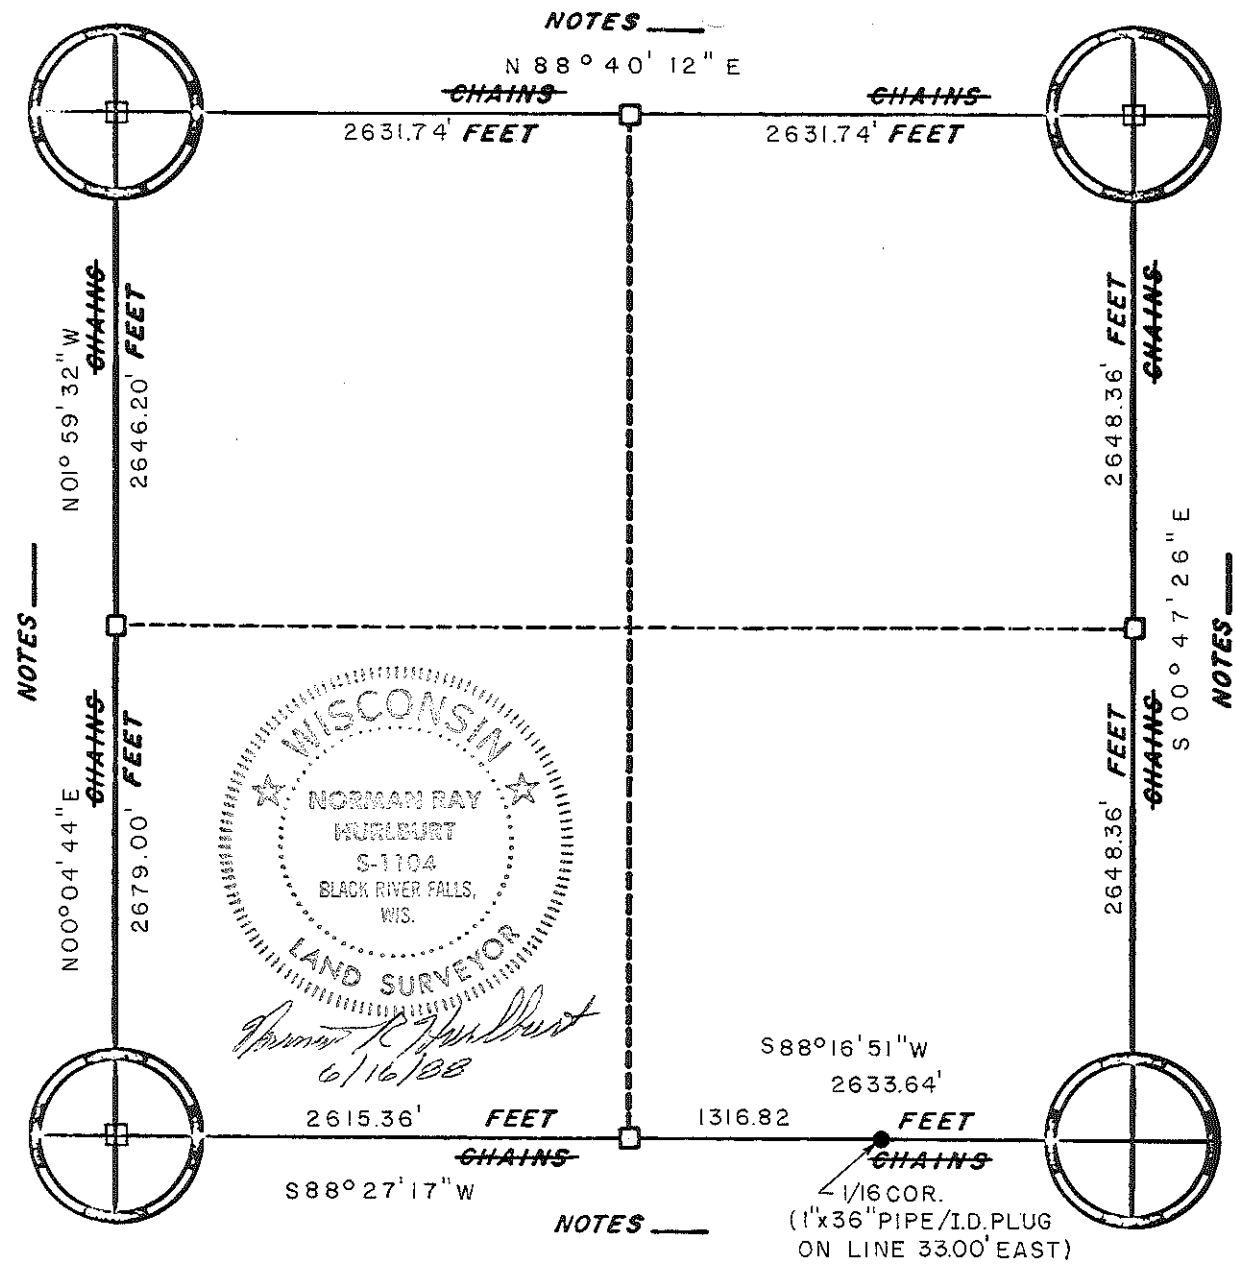

Norman R. Hurlburt
6/16/98



- HARRISON MONUMENT
- 3/4" x 30 PIPE / I.D. PLUG


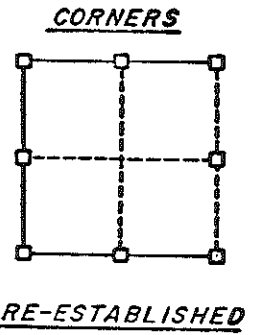


ORIGINAL SURVEY DATA

BY _____
DATE _____


SURVEYED BY N. R. HURLBURT D. W. MELICHAR	CONTRACT DATE	COUNTY MONROE	TOWN-VILLAGE-CITY LITTLE FALLS	SECTION 2 2	TOWNSHIP 19 N	RANGE 5 W
---	---------------	---------------	-----------------------------------	----------------	------------------	--------------

NOTES _____

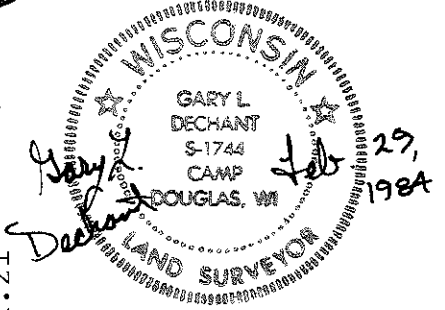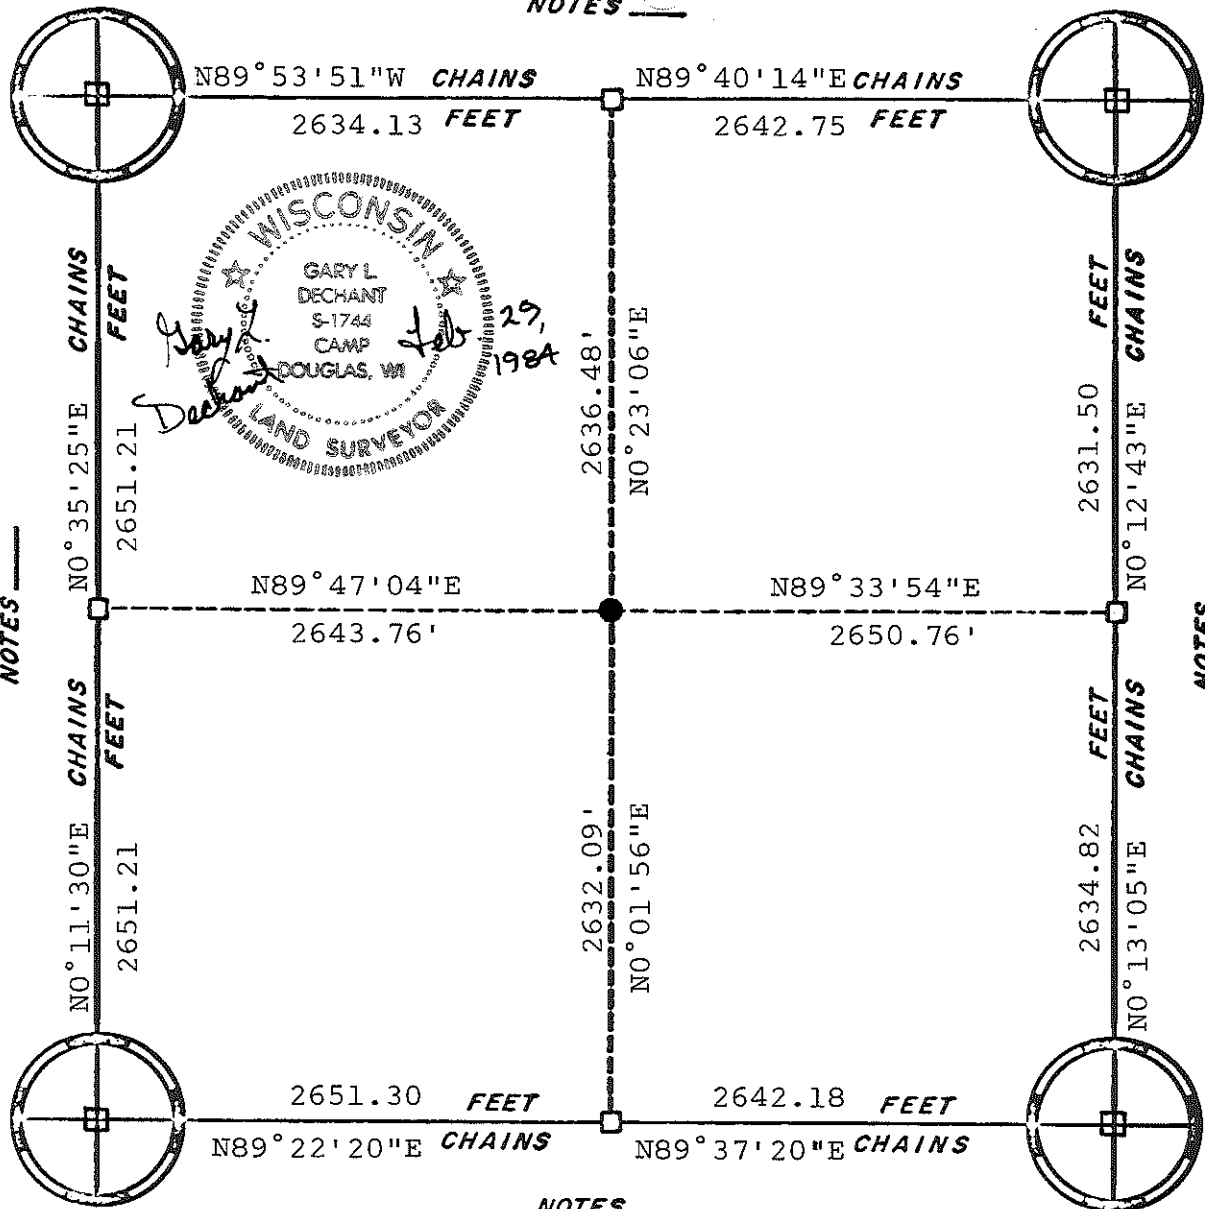

- = Harrison Monument
- = 1 1/4" x 30" round iron bar

CORNERS

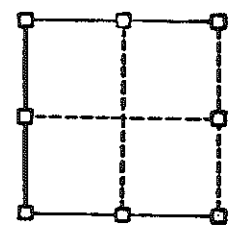

RE-ESTABLISHED

NOTES _____

NOTES _____

NOTES _____

ORIGINAL SURVEY DATA

BY _____
DATE _____

SURVEYED BY L. A. Feddersen G. L. Dechant	CONTRACT DATE Feb. 29, 1984	COUNTY MONROE [REDACTED]	TOWN- VILLAGE CITY Little Falls	SECTION 24	TOWNSHIP 19N	RANGE 5W
---	--------------------------------	-----------------------------	---	---------------	-----------------	-------------