

CERTIFICATE

CERTIFIED LAND CORNER

No. 86

41801220020

I, Lawrence A. Feddersen, do hereby certify that on the 12 day of September 19 77, I found (evidence) (no evidence) of the S 1/4 corner of Section 22, T 18 N, R 1 E Fourth Principal Meridian, and I re-established said corner according to the Wisconsin Statutes as shown and described hereon.

History of corner establishment since Original Government Survey

None

Description of corner evidence found:

Set at three-way fence corner.

Dated this 31 day of August 1981

Lawrence A. Feddersen



Registered Land Surveyor

COUNTY SURVEYOR FORM NO. 1

Description of corner and witness monuments, references and accessories used to perpetuate the original or re-established location of this corner:

Witnesses to corner location:

- Lawrence Feddersen
Douglas Malliet
Thomas Mangene
Timothy Fisher

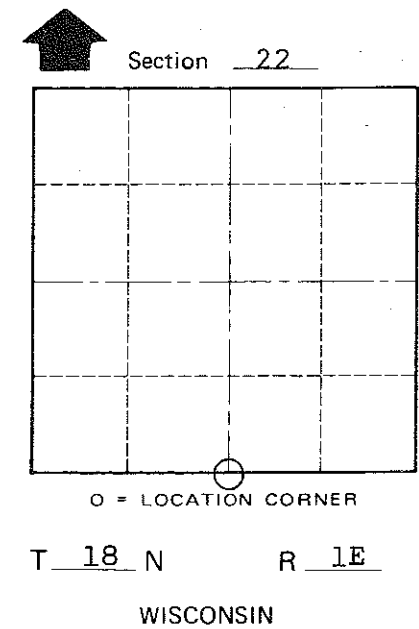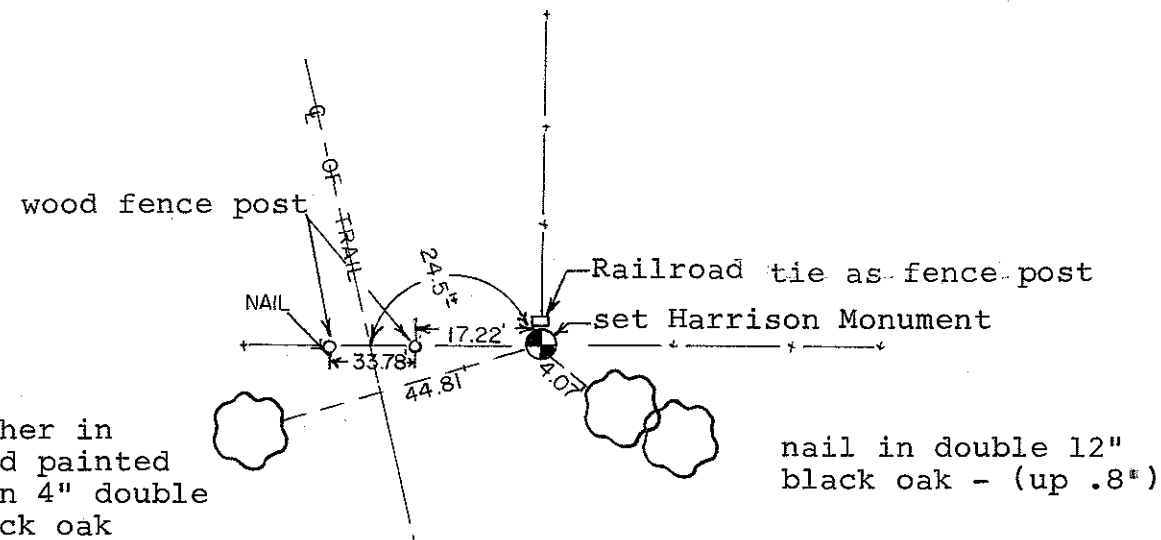

Approved: HARLEY A. SIME
MONROE CO. SURVEYOR

SURVEY CONTROL ORDER

Table with 2 rows: Horizontal, Vertical

WISCONSIN COORDINATE SYSTEM

Table with 5 columns: Corner, East (X), North (Y), Elevation (Z), Zone

XXXXXX Town of Byron

County of Monroe