

21804072000

I, Mark R. Heidecke, do hereby certify that on the 7th day of December 19 79, I found ~~XXXXXX~~ (no evidence) of the West 1/4 corner of Section 8, T. 18 N., R. 4 W. Fourth Principal Meridian, and I re-established said corner according to the Wisconsin Statutes as shown and described hereon.

Dated this 9th day of January 1980.

Mark R Heidecke

Registered Land Surveyor  
Title

History of corner establishment since Original Government Survey

No subsequent history of monument perpetuation since the Original U.S. Government Survey in Monroe County.

Description of corner evidence found:

A Harrison Monument was set half-way and on a straight line between the Northwest and Southwest Section corners of Section 8. Coils of old fence wire were found in this vicinity although the exact location of the old fence was impossible to establish. This location is compatible with the interior occupation within Section 8.

Description of corner and witness monuments, references and accessories used to perpetuate the original or re-established location of this corner:

Witnesses to corner location:

Mark Heidecke

Lawrence Feddersen

Nail and Washer in Blaze  
in 7" White Oak

Nail and Washer in Blaze  
in 9" White Oak

26.70'

12.93'

22.23'


Nail and Washer in Blaze  
in 9" White Oak

7.59'

Nail and Washer in Blaze  
in 6" White Oak

Harrison Monument Set  
West 1/4 Corner Section 8

SIGN PLACED 11-08-89 ML

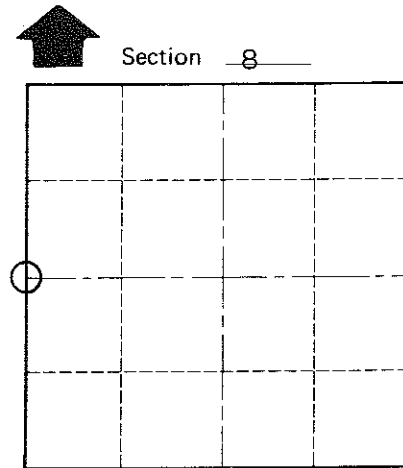

O = LOCATION CORNER

T 18 N R 4 W

WISCONSIN

COUNTY SURVEYOR FORM NO. 1

SURVEY CONTROL ORDER

Horizontal	_____
Vertical	_____

WISCONSIN COORDINATE SYSTEM

Corner	East (X)	North (Y)	Elevation (Z)	Zone
Control Sta. Name				

~~XXXXXX~~ of Town of Little Falls

County of Monroe